



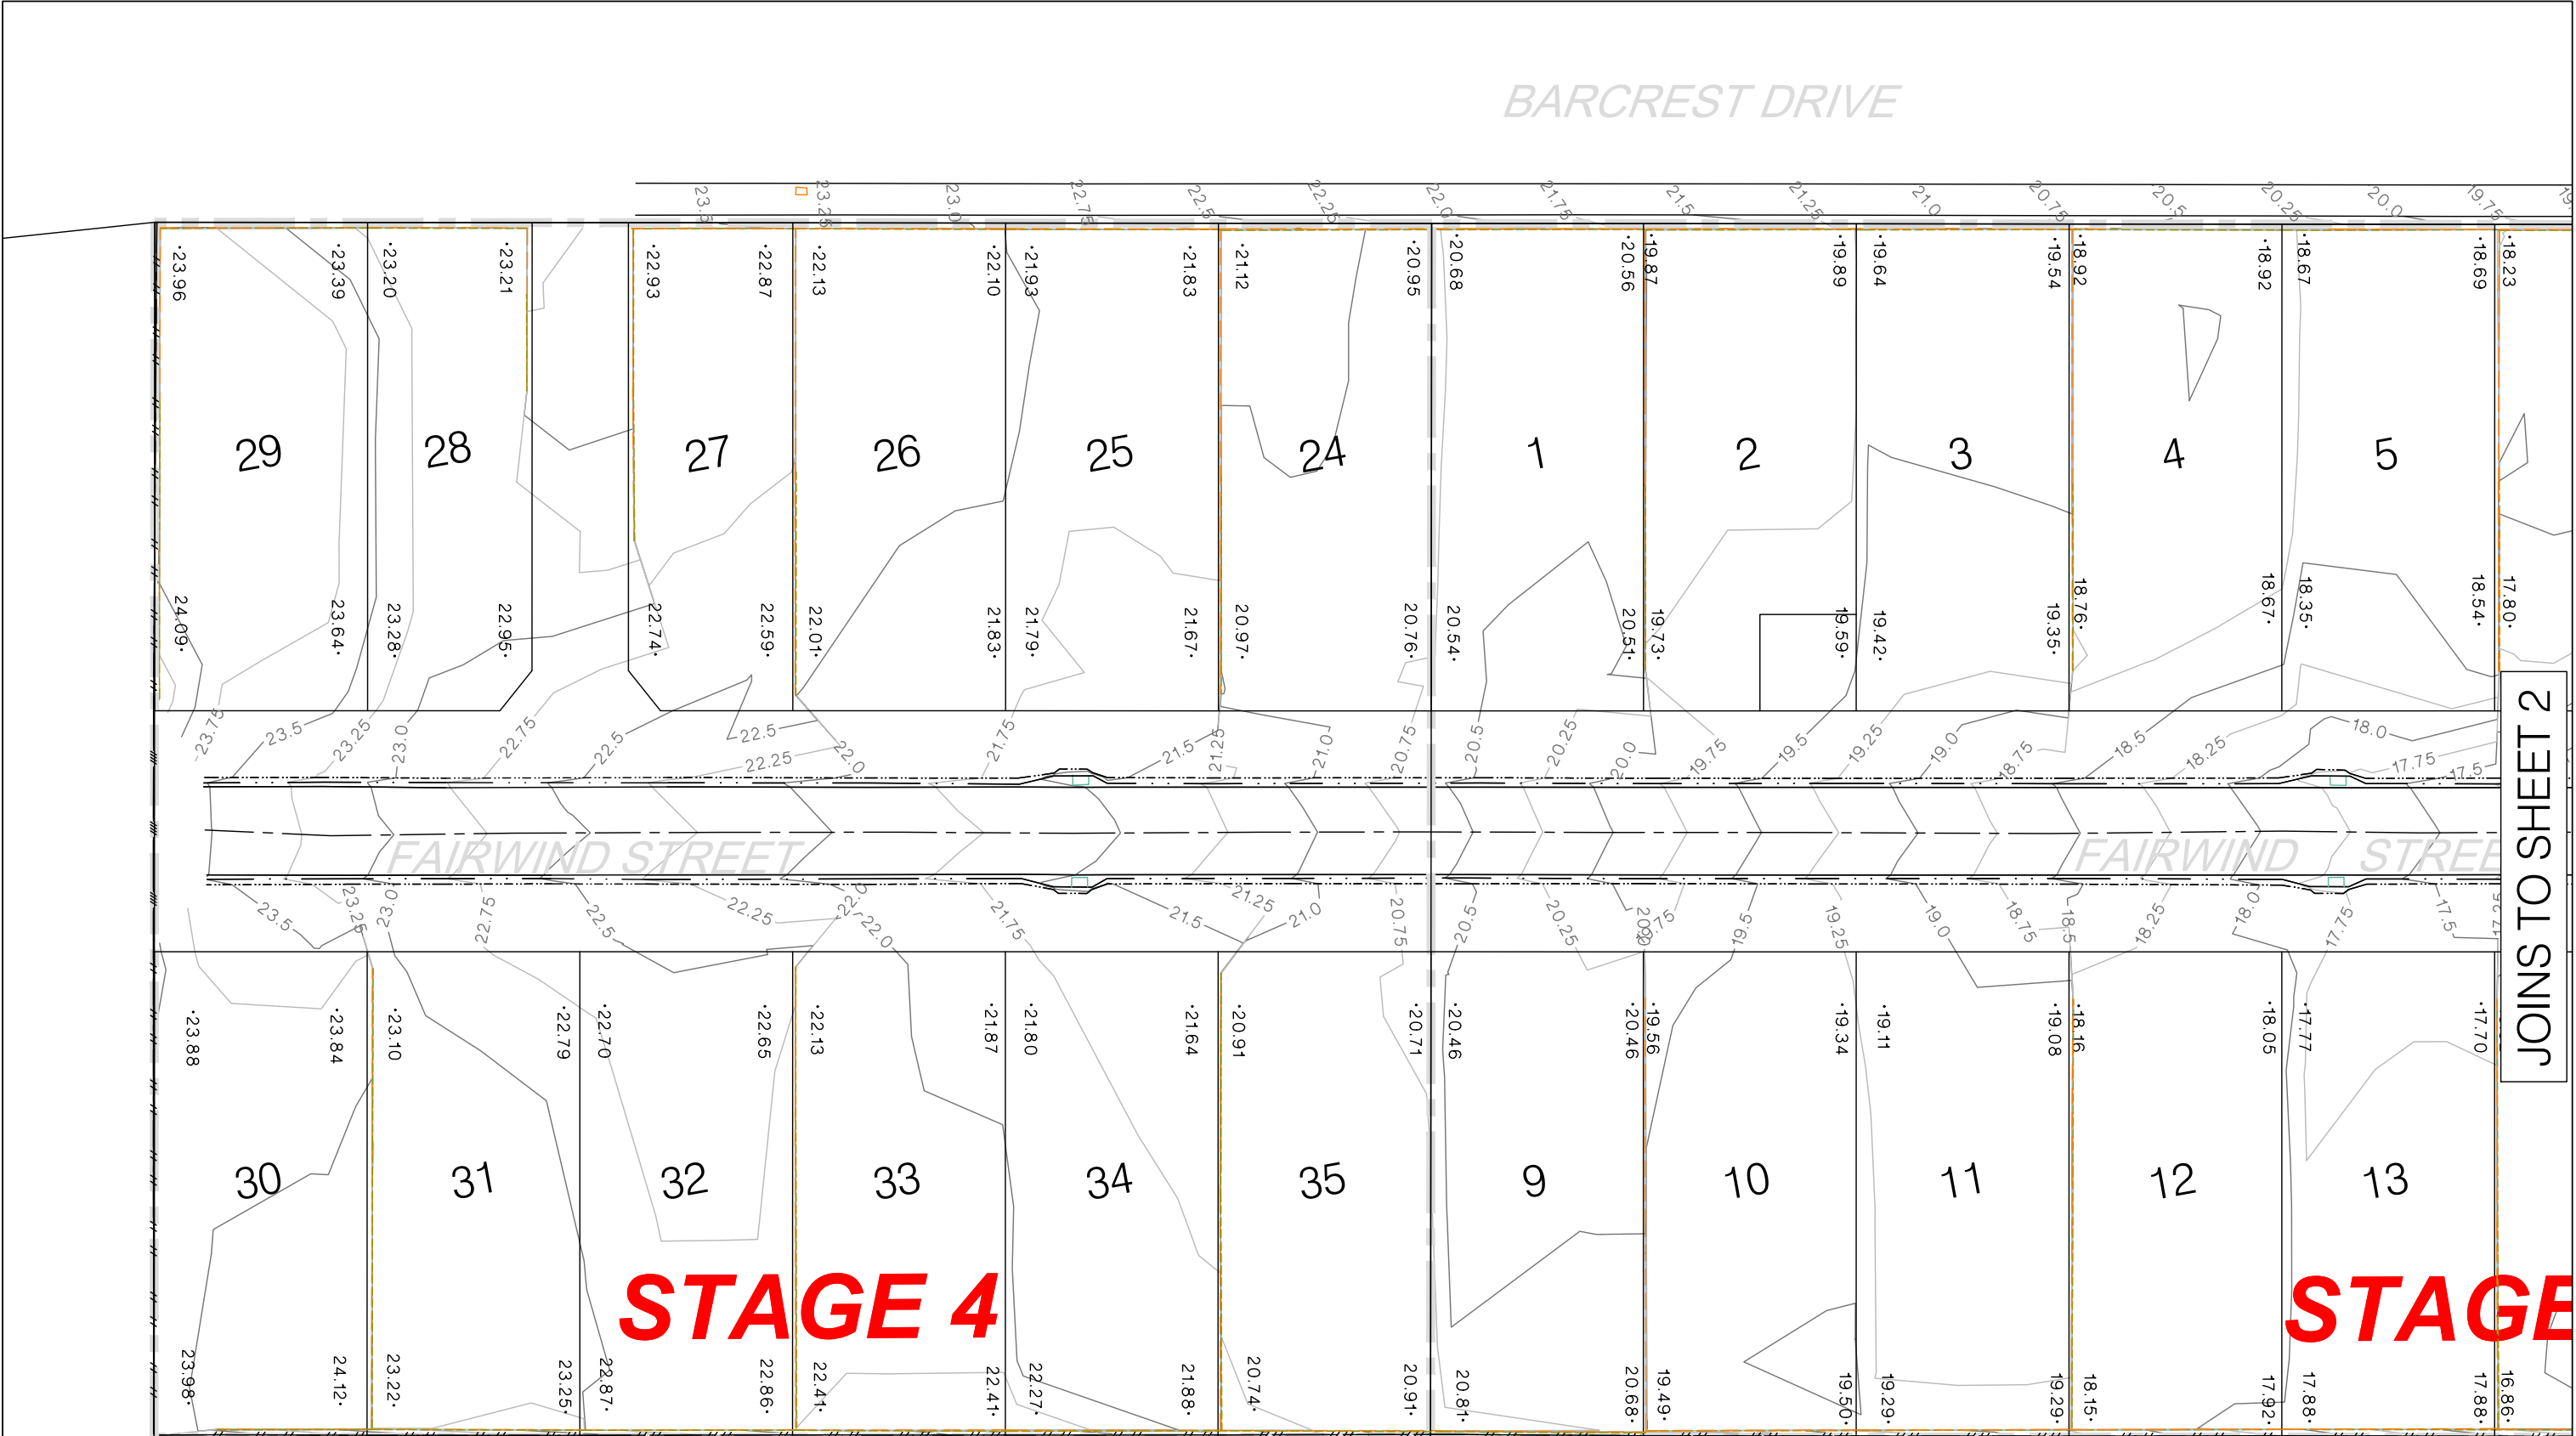

The information contained within these as-constructed drawings are generally in accordance with the works that have been carried out on site to date. However, we note they are preliminary in nature and they are subjected to final changes and defect rectification. It is expected that the works detailed will be completed in their entirety within 3 months of the signed date.  RPEQ (signature) 4555 19/05/2026 RPEQ No. Date:									
---	--	--	--	--	--	--	--	--	--

BARCREST DRIVE

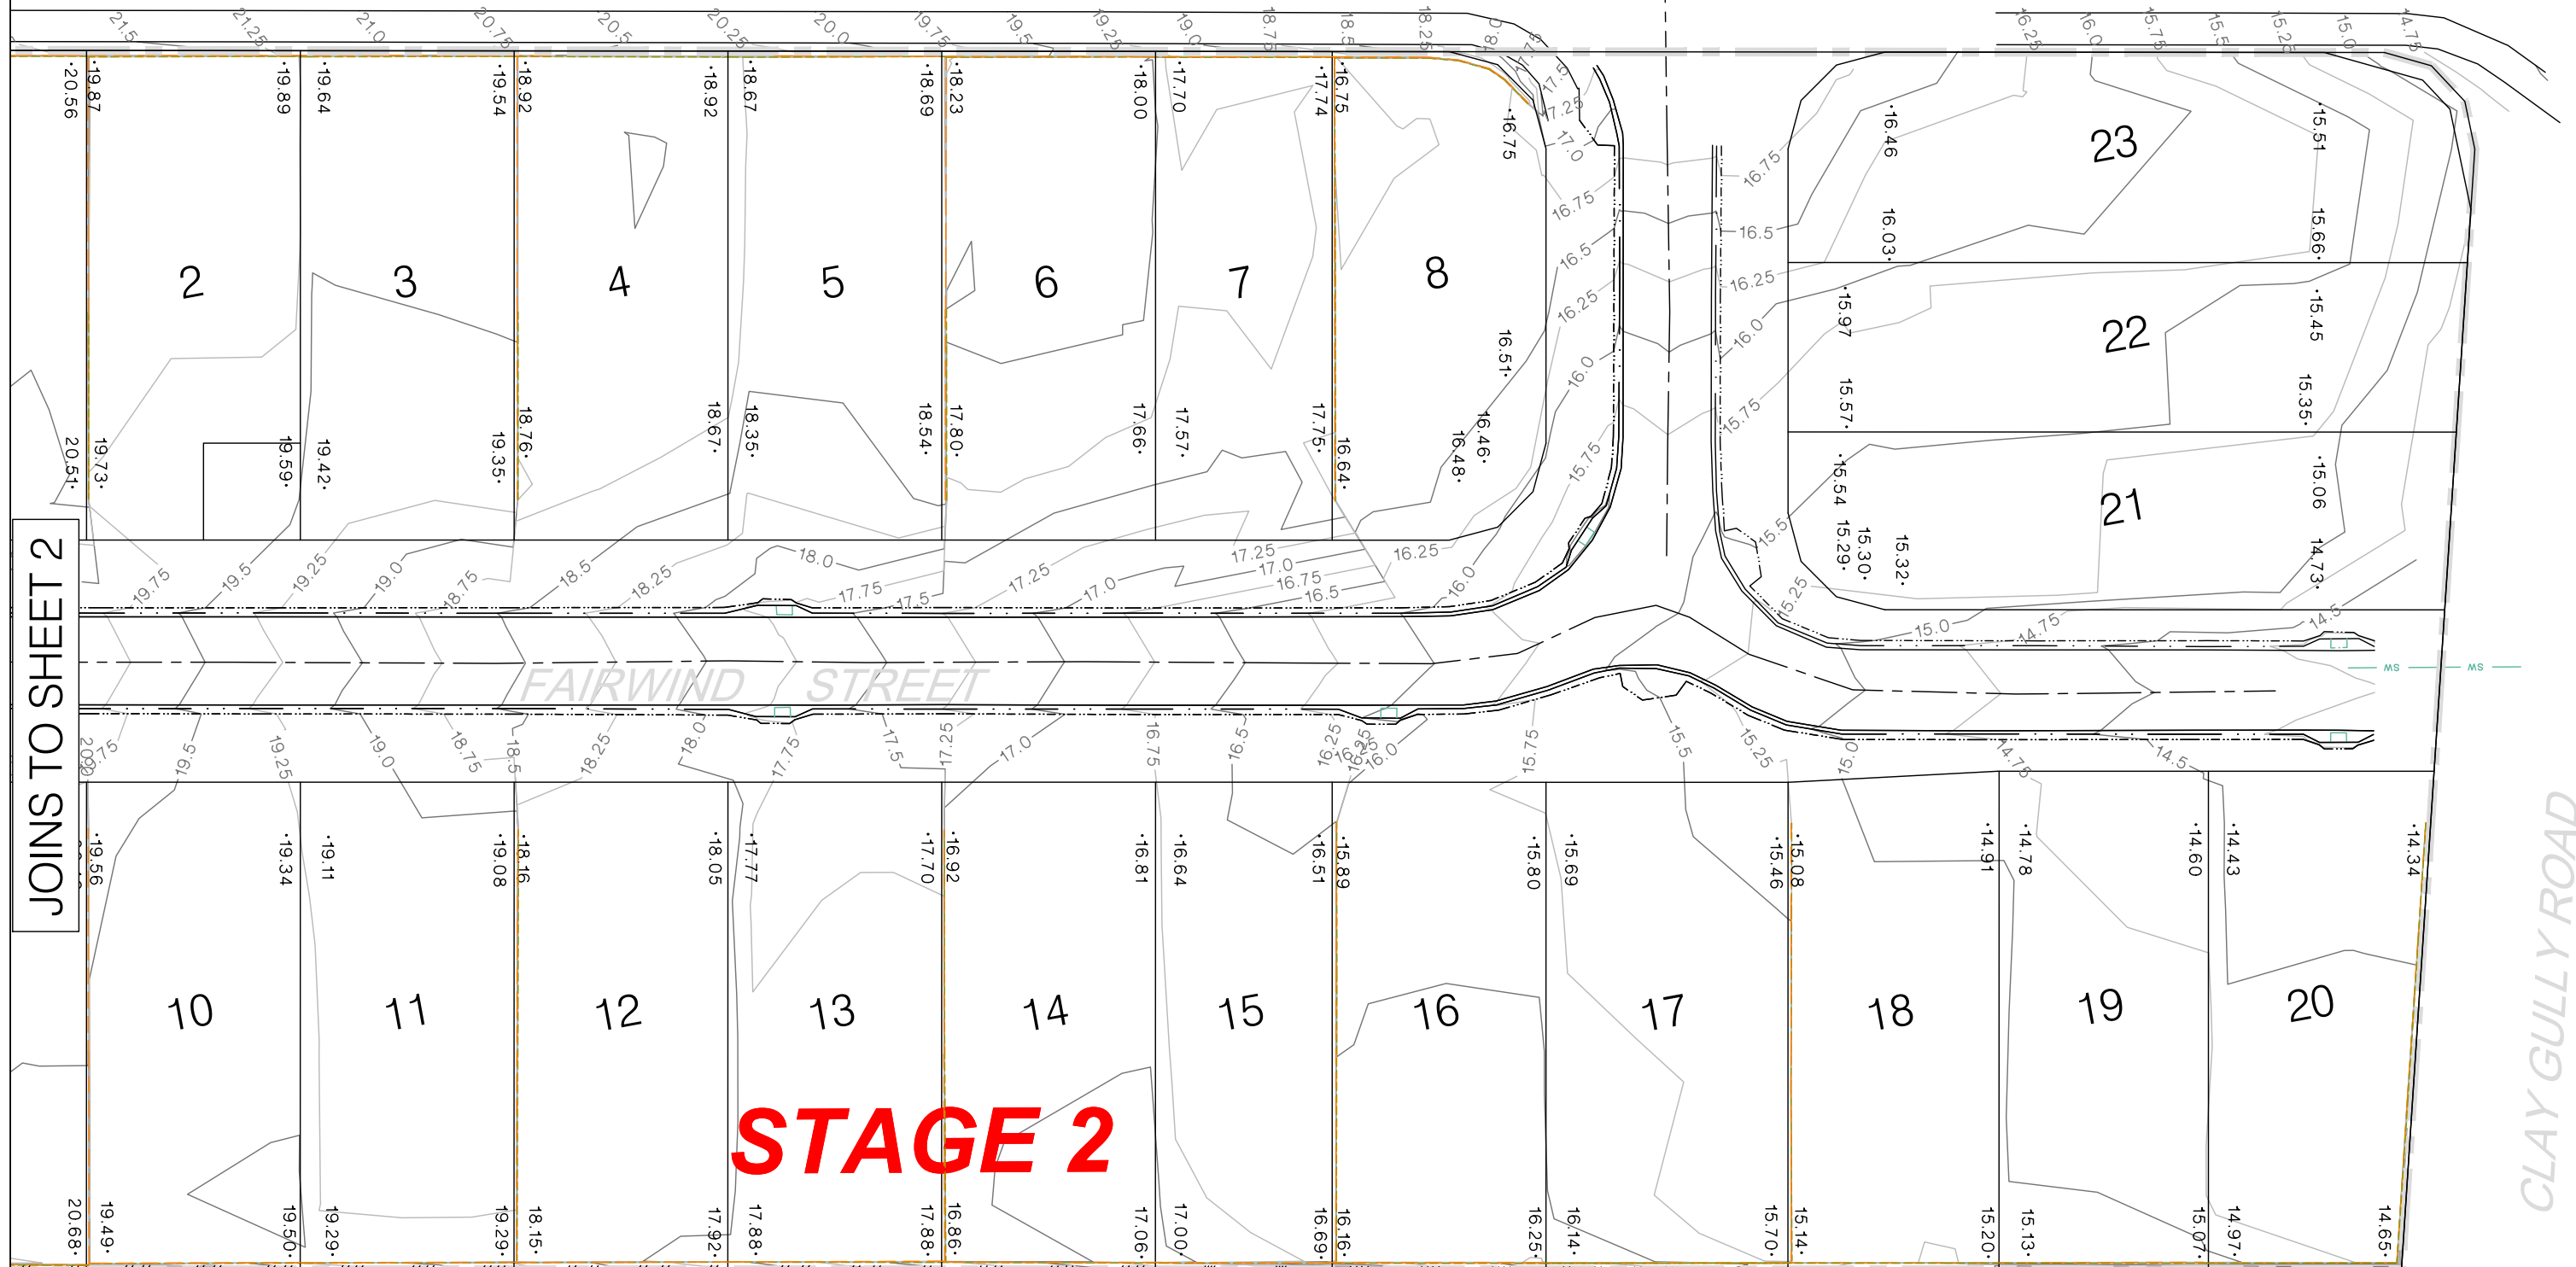

JOINS TO SHEET 2

STAGE 2

CLAY GULLY ROAD

The information contained within these as-constructed drawings are generally in accordance with the works that have been carried out on site to date. However, we note they are preliminary in nature and they are subjected to final changes and defect rectification. It is expected that the works detailed will be completed in their entirety within 3 months of the signed date.

BRP
RPEQ 4555 19/05/2026
RPEQ (signature) RPEQ No. Date:



BOTTOM WALL ---
TOP WALL ---

Progressive Ascon TOPOGRAPHY SHEET 2



Updated with Field data:
12/05/2026
Project Name: BARCREST STAGE 2 &4
Scale: 1:400 (A3)
File: BRSS8434-000-106-1
Drawn: MEA
Date: 18/05/2026