


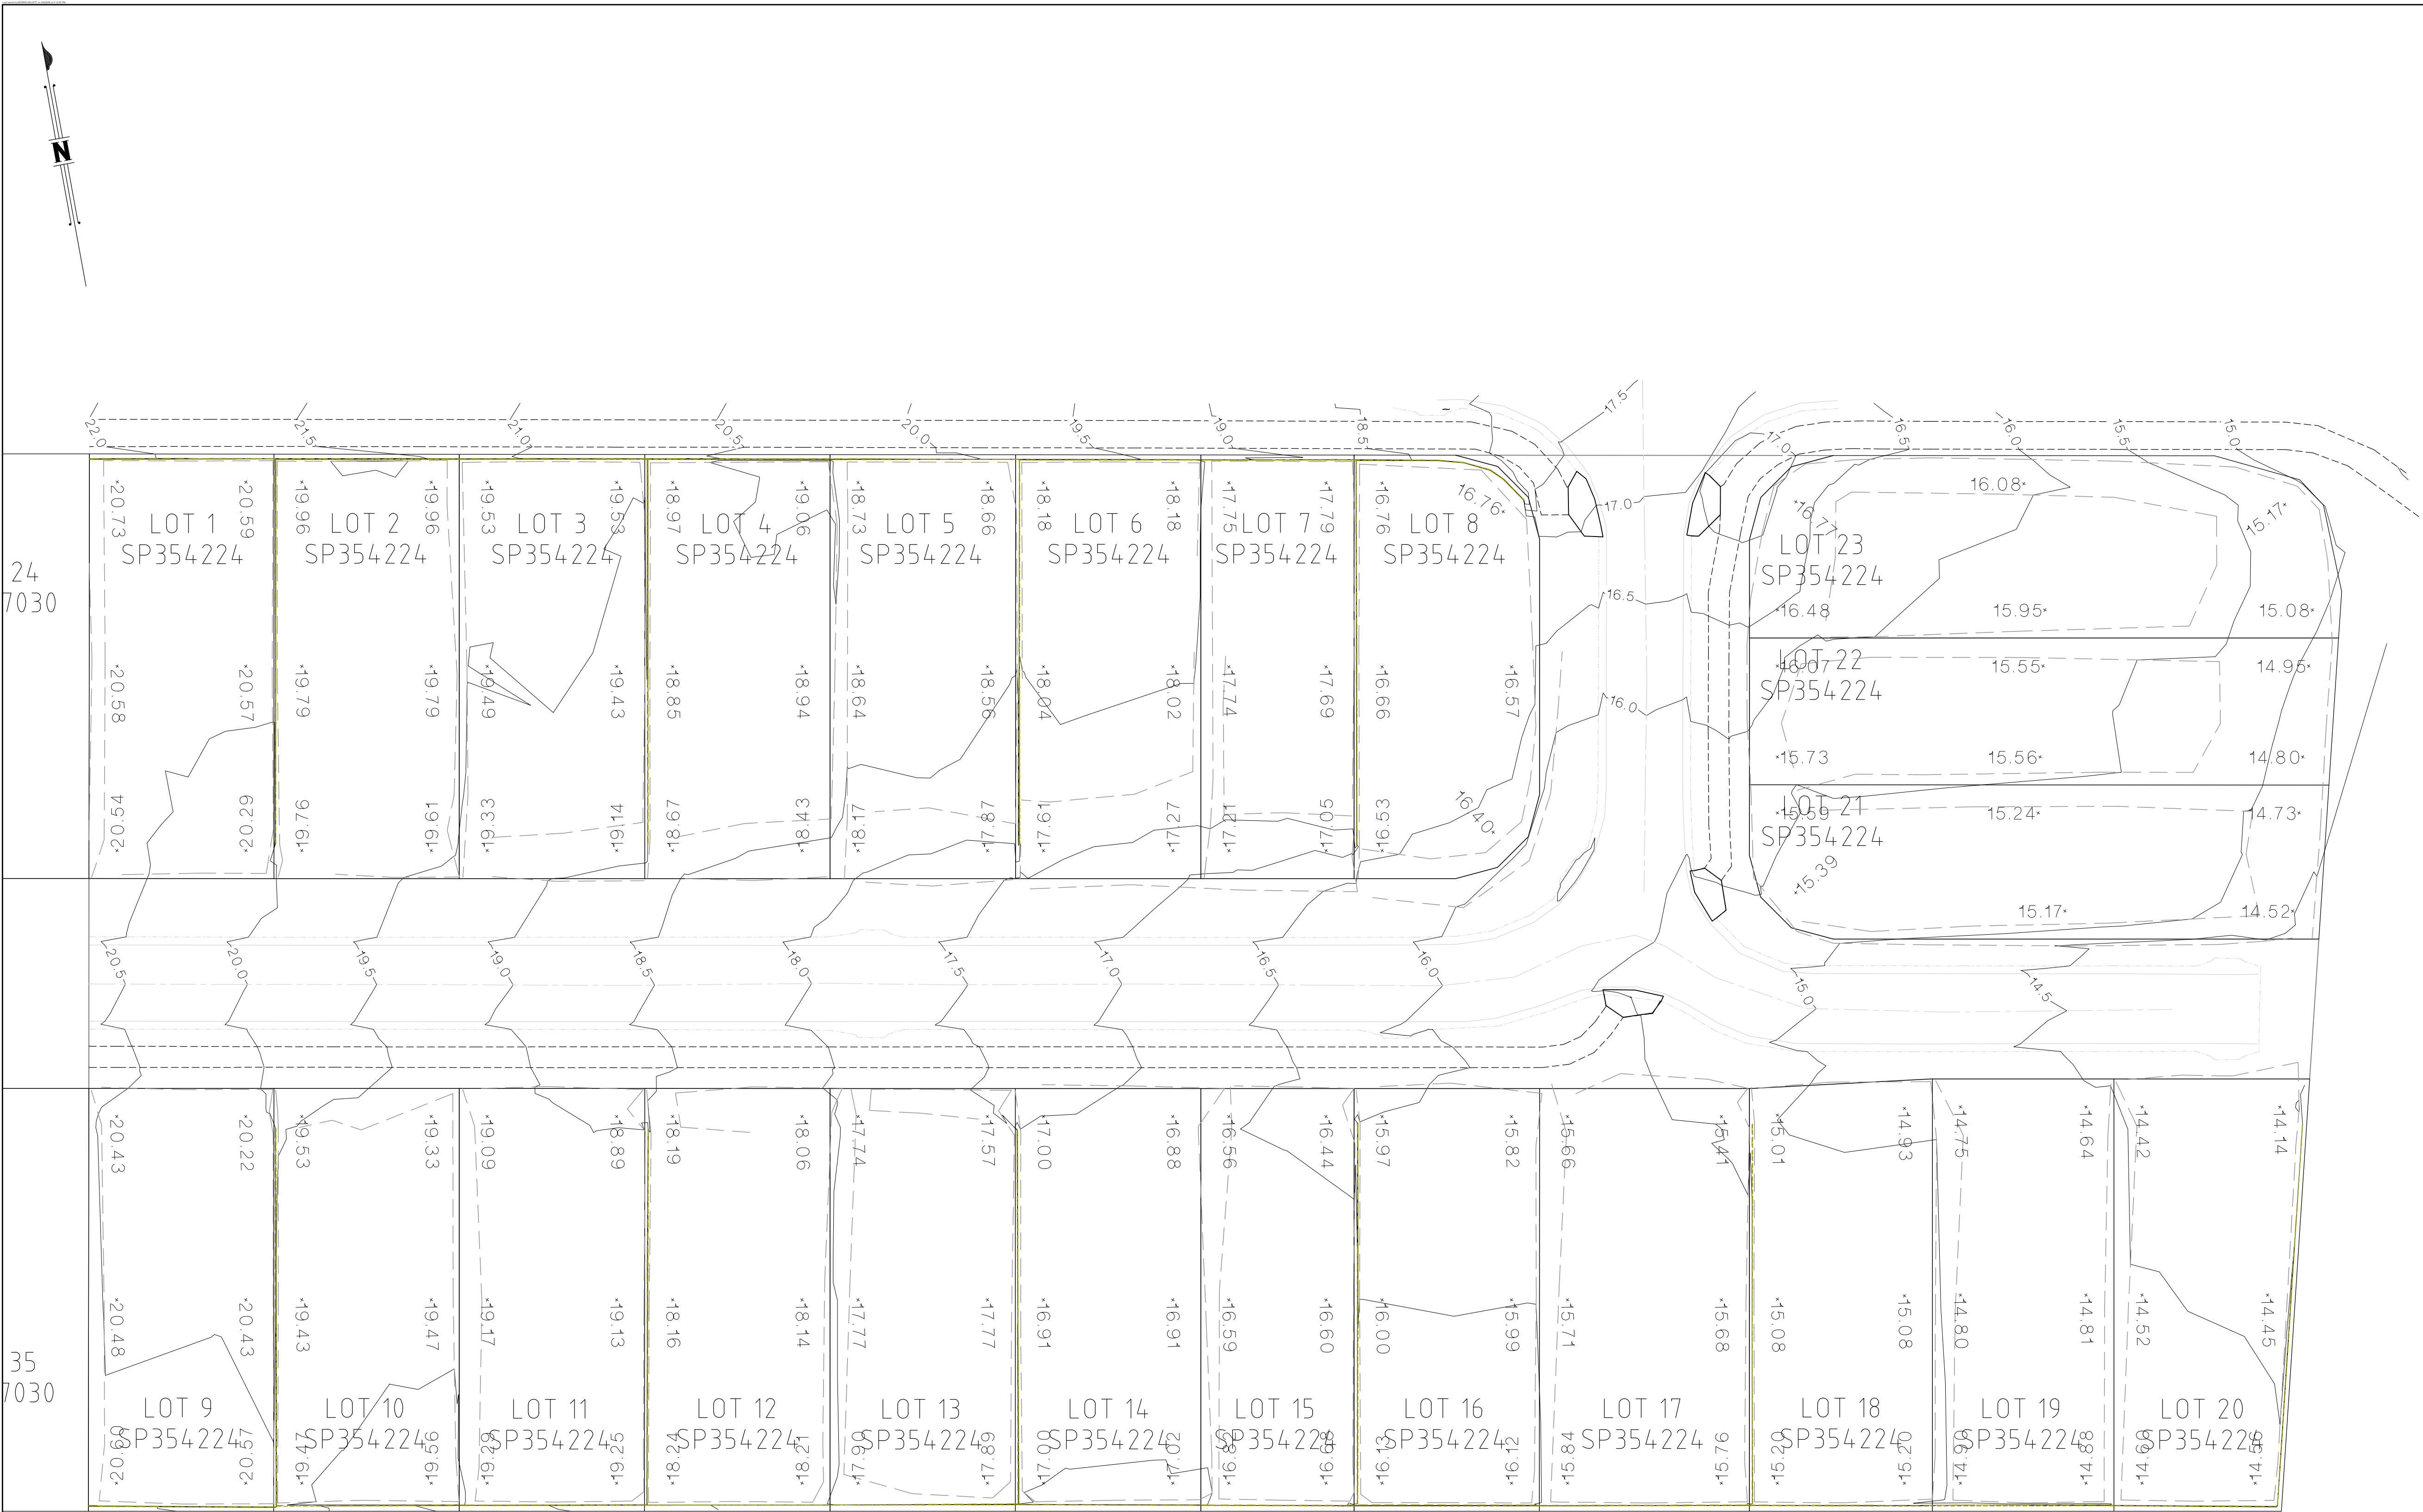

ENGINEER'S CERTIFICATION

I,, hereby certify that the as-constructed details shown on this drawing are a true and accurate record of the construction works, in compliance with the contract documents, approved drawings and approved design.

RPEQ (signature) RPEQ No. Date:

REGISTERED CADASTRAL SURVEYOR (QLD) CERTIFICATION

MNG QLD & NSW Pty Ltd, hereby certify that the vertical and horizontal locations and dimensions shown on this plan are a true and accurate record and were located by survey.

R. G. Anderson
Authorised Delegate Reg. Surveyor No. 4118 Date: 04/08/2026
MNG QLD & NSW Pty Ltd
Registered QLD Surveyor Corporation

0m 5 10 15m

SCALE 1:250 (A1)

CLIENT

**ORCHARD
PROPERTY GROUP**

PROJECT

**AS CONSTRUCTED
TOPOGRAPHY**
OF
**STAGE 2,
4 BARCREST DRIVE, VICTORIA POINT**

LEGEND

- BOTTOM OF WALL
- TOP OF WALL
- LIP OF KERB
- BACK OF KERB
- EDGE OF CONCRETE
- EDGE OF ROCK
- CONTOURS
- CHANGE OF GRADE
- BOTTOM OF BANK
- TOP OF BANK
- CROWN OF ROAD

ENGINEERING FIRM:

**BURCHILLS ENGINEERING
SOLUTIONS PTY LTD**

1	04/08/2026	MJK	RA	RA	04/08/2026
REV	DATE	DRAWN	CHECKED	APPROVED	SURVEY DATE

MNG

Perth | Brisbane | Melbourne | Sydney | Broome | South West WA

Brisbane Office
Level 3
108 Wickham Street
Fortitude Valley QLD 4006
p: (07) 3842 1000
e: brisbane@mngsurvey.com.au
w: mngsurvey.com.au

LEVEL DATUM AHD	LOCAL AUTHORITY REDLAND C.C.
LEVEL ORIGIN -	CONTOUR INTERVAL 0.5 Metre
MERIDIAN MGA2020	CO-ORD SYSTEM MGA ZONE 56
UDN	SHEET 1 OF 1

BRSS8434-000-113-1

© MNG Survey 2026