


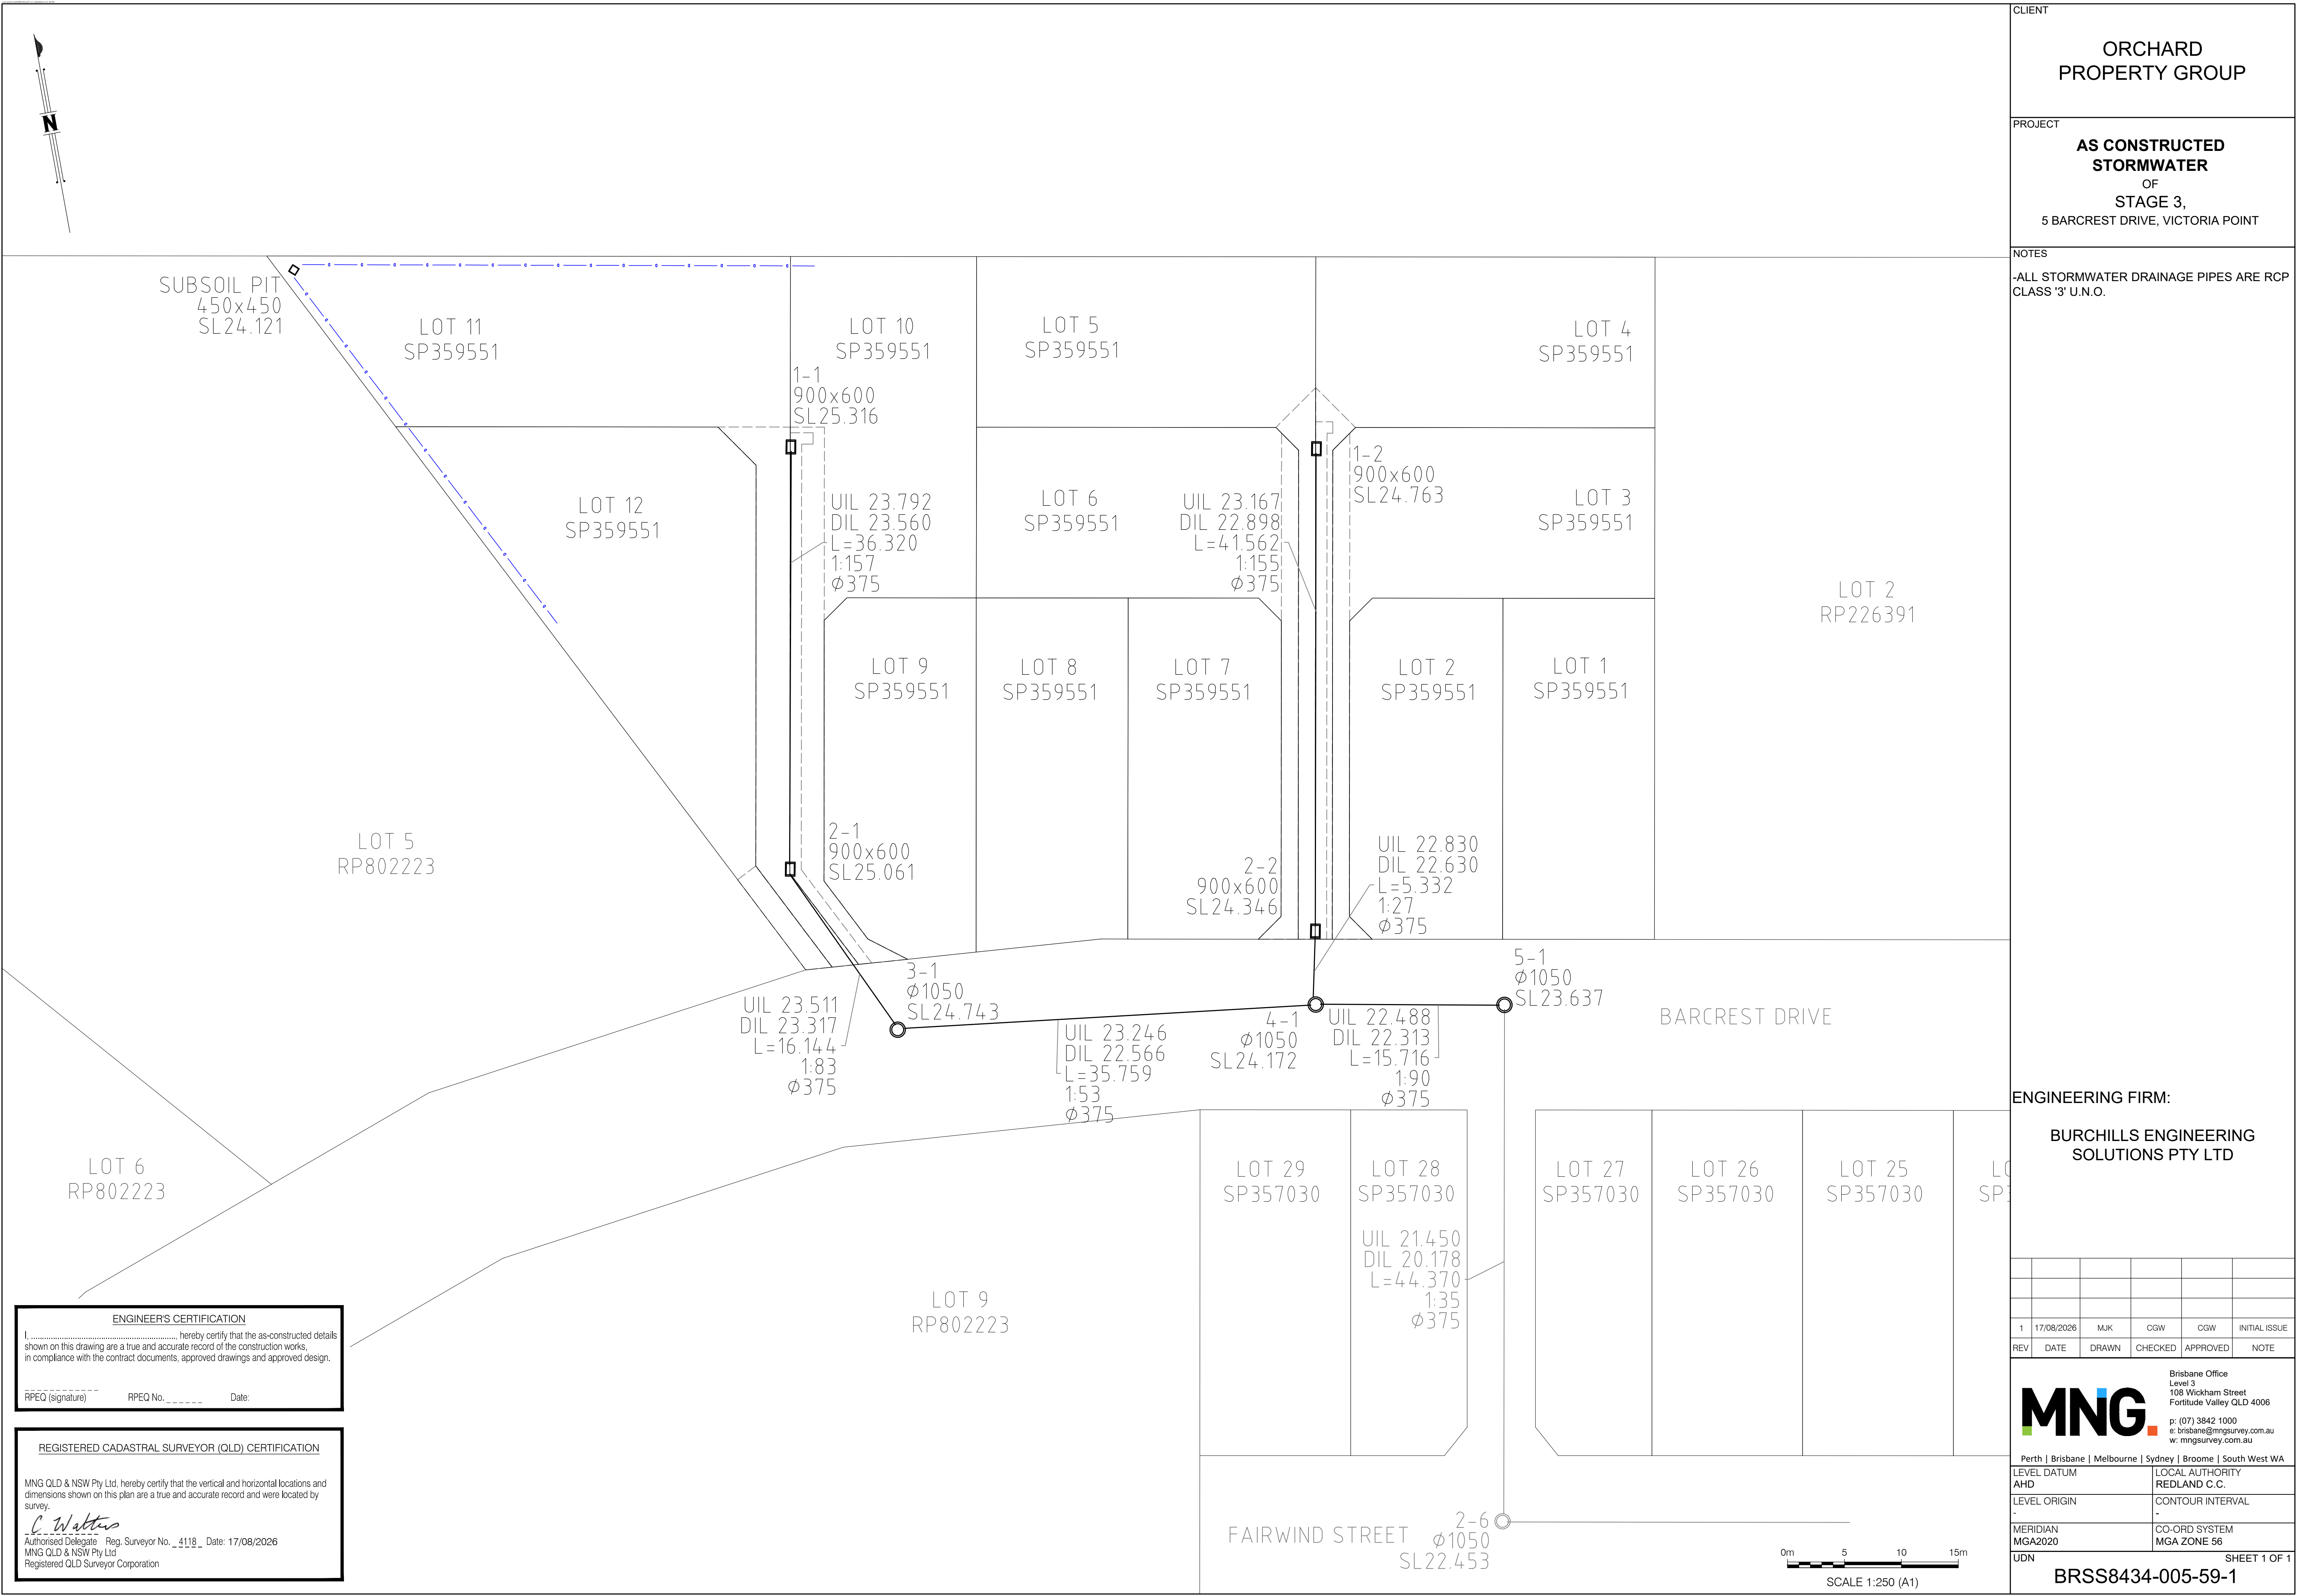

ORCHARD
PROPERTY GROUP

**AS CONSTRUCTED
STORMWATER
OF
STAGE 3,
CREST DRIVE, VICTORIA**

-ALL STORMWATER DRAINAGE PIPES ARE RCP
CLASS '3' U.N.O.

BURCHILLS ENGINEERING
SOLUTIONS PTY LTD

1	17/08/2026	MJK	CGW	CGW	INITIAL ISSUE
REV	DATE	DRAWN	CHECKED	APPROVED	NOTE

MNG

Brisbane Office
Level 3
108 Wickham Street
Fortitude Valley QLD 4006

p: (07) 3842 1000
e: brisbane@mngsurvey.com.au
w: mngsurvey.com.au

Perth Brisbane Melbourne Sydney Broome South West WA	
LEVEL DATUM AHD	LOCAL AUTHORITY REDLAND C.C.
LEVEL ORIGIN -	CONTOUR INTERVAL -
MERIDIAN MGA2020	CO-ORD SYSTEM MGA ZONE 56
JDN	
SHEET 1 OF 1	

BRSS8434-005-59-1