




CLIENT

ORCHARD
PROPERTY GROUP

PROJECT

**AS CONSTRUCTED
TOPOGRAPHY**
OF
STAGE 3
5 BARCREST DRIVE, VICTORIA POINT

- LEGEND
- BOTTOM OF WALL
 - TOP OF WALL
 - LIP OF KERB
 - BACK OF KERB
 - EDGE OF CONCRETE
 - DRAIN CENTRELINE
 - CONTOURS
 - CHANGE OF GRADE
 - BOTTOM OF BANK
 - TOP OF BANK

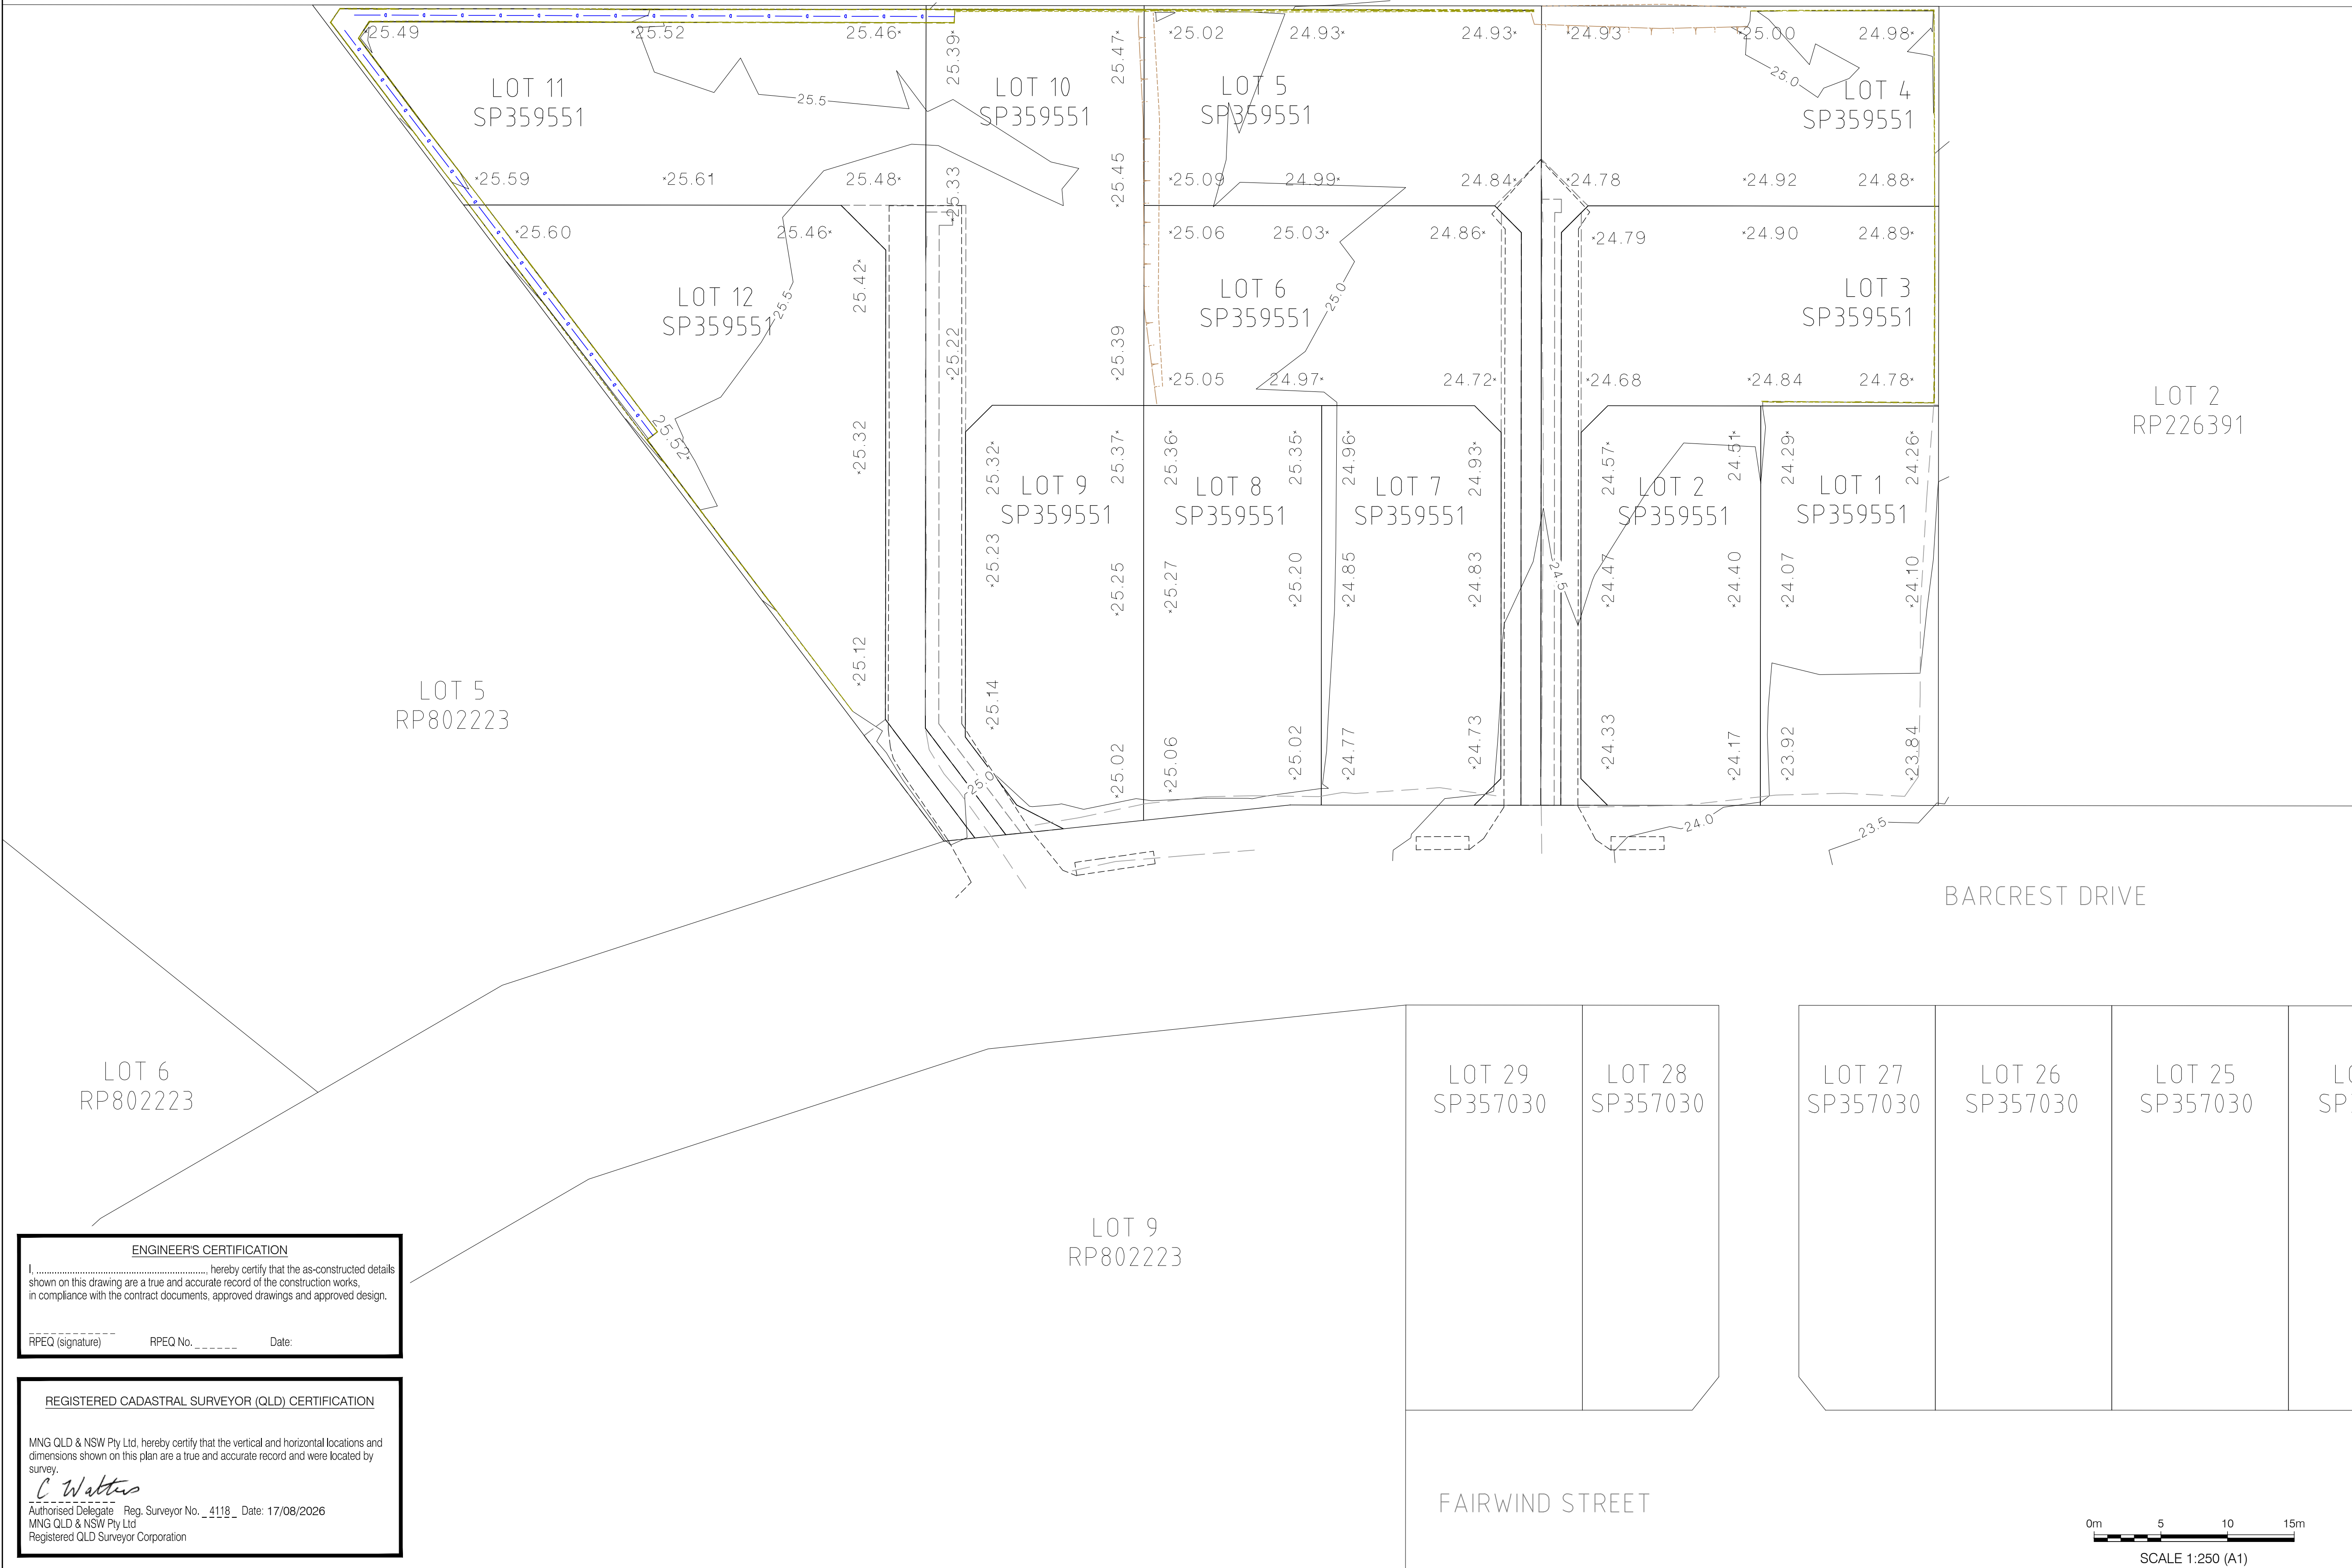

ENGINEER'S CERTIFICATION

I, _____, hereby certify that the as-constructed details shown on this drawing are a true and accurate record of the construction works, in compliance with the contract documents, approved drawings and approved design.

RPEQ (signature) _____ RPEQ No. _____ Date: _____

REGISTERED CADASTRAL SURVEYOR (QLD) CERTIFICATION

MNG QLD & NSW Pty Ltd, hereby certify that the vertical and horizontal locations and dimensions shown on this plan are a true and accurate record and were located by survey.

C. Walters
Authorised Delegate Reg. Surveyor No. _ 4118 _ Date: 17/08/2026
MNG QLD & NSW Pty Ltd
Registered QLD Surveyor Corporation

ENGINEERING FIRM:

BURCHILLS ENGINEERING
SOLUTIONS PTY LTD

1	17/08/2026	MJK	CGW	CGW	INITIAL ISSUE
REV	DATE	DRAWN	CHECKED	APPROVED	NOTE



Brisbane Office
Level 3
108 Wickham Street
Fortitude Valley QLD 4006
p: (07) 3842 1000
e: brisbane@mngsurvey.com.au
w: mngsurvey.com.au

Perth | Brisbane | Melbourne | Sydney | Broome | South West WA

LEVEL DATUM	LOCAL AUTHORITY
AHD	REDLAND C.C.
LEVEL ORIGIN	CONTOUR INTERVAL
-	0.5 Metre
MERIDIAN	CO-ORD SYSTEM
MGA2020	MGA ZONE 56
UDN	SHEET 1 OF 1

BRSS8434-005-60-1

