


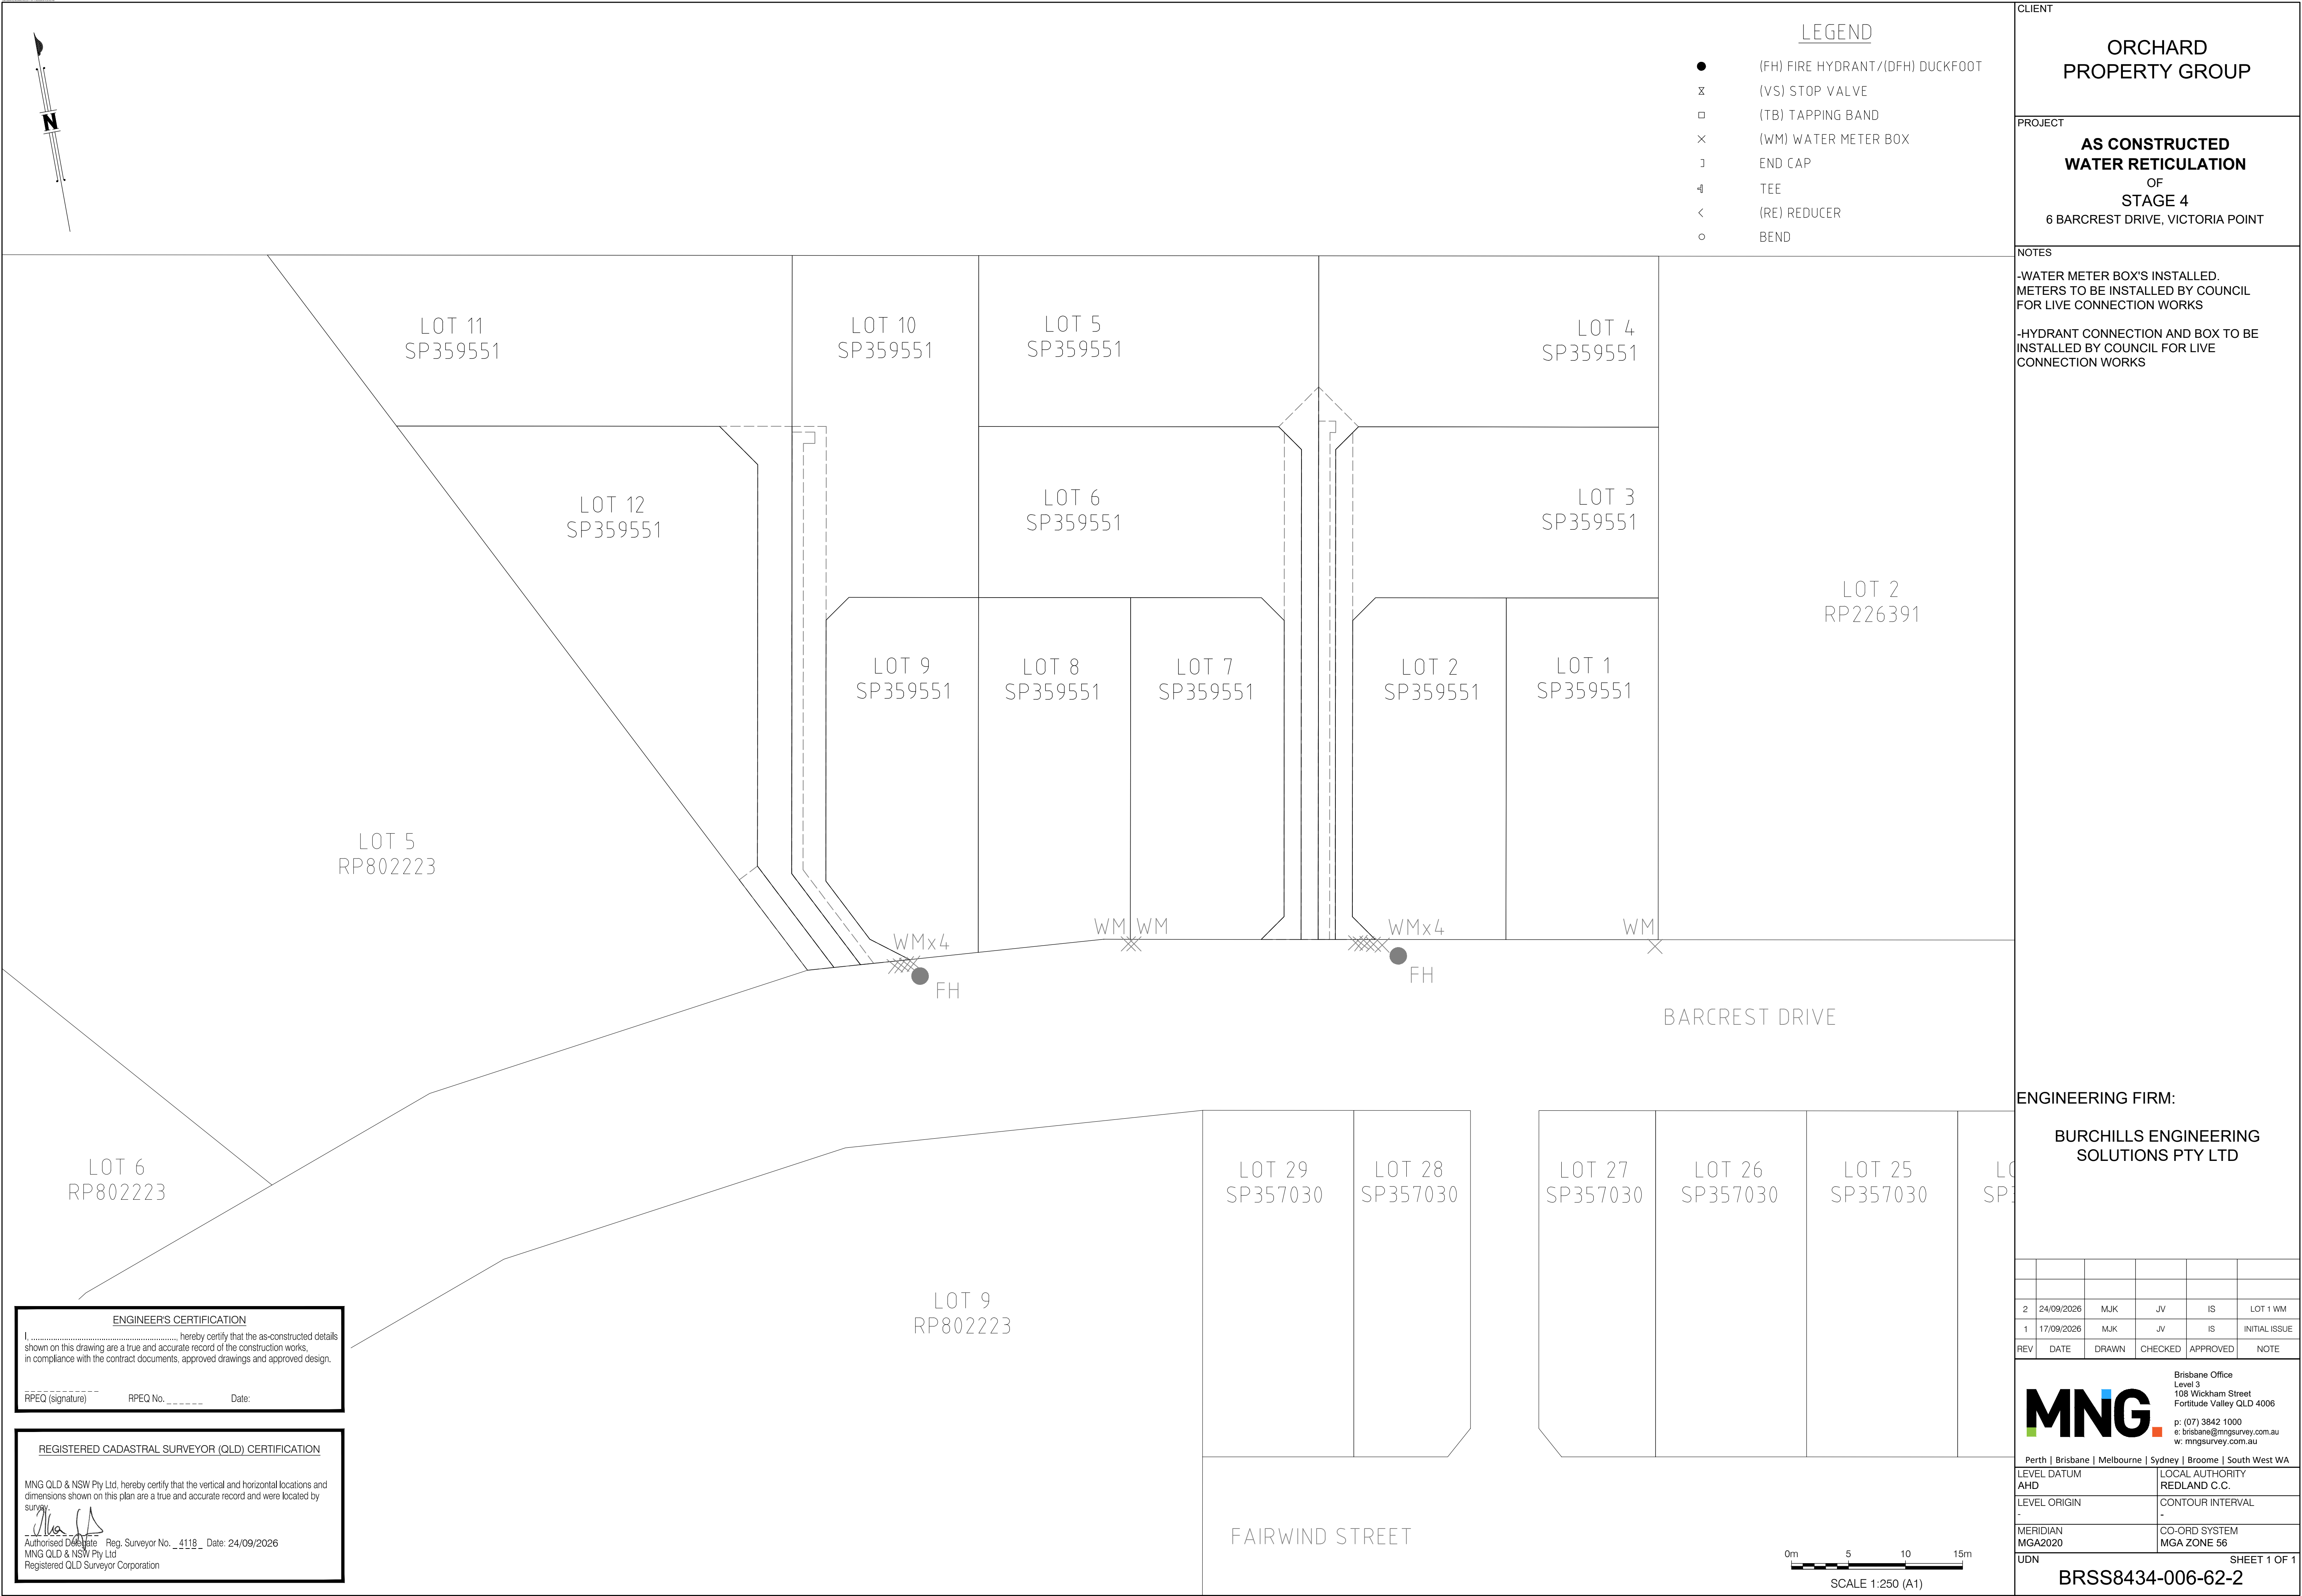

LEGEND

- (FH) FIRE HYDRANT/(DFH) DUCKFOOT
- ⌵ (VS) STOP VALVE
- (TB) TAPPING BAND
- × (WM) WATER METER BOX
- ┘ END CAP
- ├ TEE
- < (RE) REDUCER
- BEND

CLIENT
**ORCHARD
PROPERTY GROUP**

PROJECT
**AS CONSTRUCTED
WATER RETICULATION
OF
STAGE 4
6 BARCREST DRIVE, VICTORIA POINT**

NOTES
-WATER METER BOX'S INSTALLED.
METERS TO BE INSTALLED BY COUNCIL
FOR LIVE CONNECTION WORKS

-HYDRANT CONNECTION AND BOX TO BE
INSTALLED BY COUNCIL FOR LIVE
CONNECTION WORKS

ENGINEERING FIRM:
**BURCHILLS ENGINEERING
SOLUTIONS PTY LTD**

2	24/09/2026	MJK	JV	IS	LOT 1 WM
1	17/09/2026	MJK	JV	IS	INITIAL ISSUE
REV	DATE	DRAWN	CHECKED	APPROVED	NOTE

Brisbane Office
Level 3
108 Wickham Street
Fortitude Valley QLD 4006
p: (07) 3842 1000
e: brisbane@mngsurvey.com.au
w: mngsurvey.com.au

Perth | Brisbane | Melbourne | Sydney | Broome | South West WA

LEVEL DATUM AHD	LOCAL AUTHORITY REDLAND C.C.
LEVEL ORIGIN -	CONTOUR INTERVAL
MERIDIAN MGA2020	CO-ORD SYSTEM MGA ZONE 56
UDN	SHEET 1 OF 1

BRSS8434-006-62-2

ENGINEER'S CERTIFICATION
I, _____, hereby certify that the as-constructed details shown on this drawing are a true and accurate record of the construction works, in compliance with the contract documents, approved drawings and approved design.

RPEQ (signature) _____ RPEQ No. _____ Date: _____

REGISTERED CADASTRAL SURVEYOR (QLD) CERTIFICATION
MNG QLD & NSW Pty Ltd, hereby certify that the vertical and horizontal locations and dimensions shown on this plan are a true and accurate record and were located by survey.

Authorised Delegate Reg. Surveyor No. _ 4118 _ Date: 24/09/2026
MNG QLD & NSW Pty Ltd
Registered QLD Surveyor Corporation

