


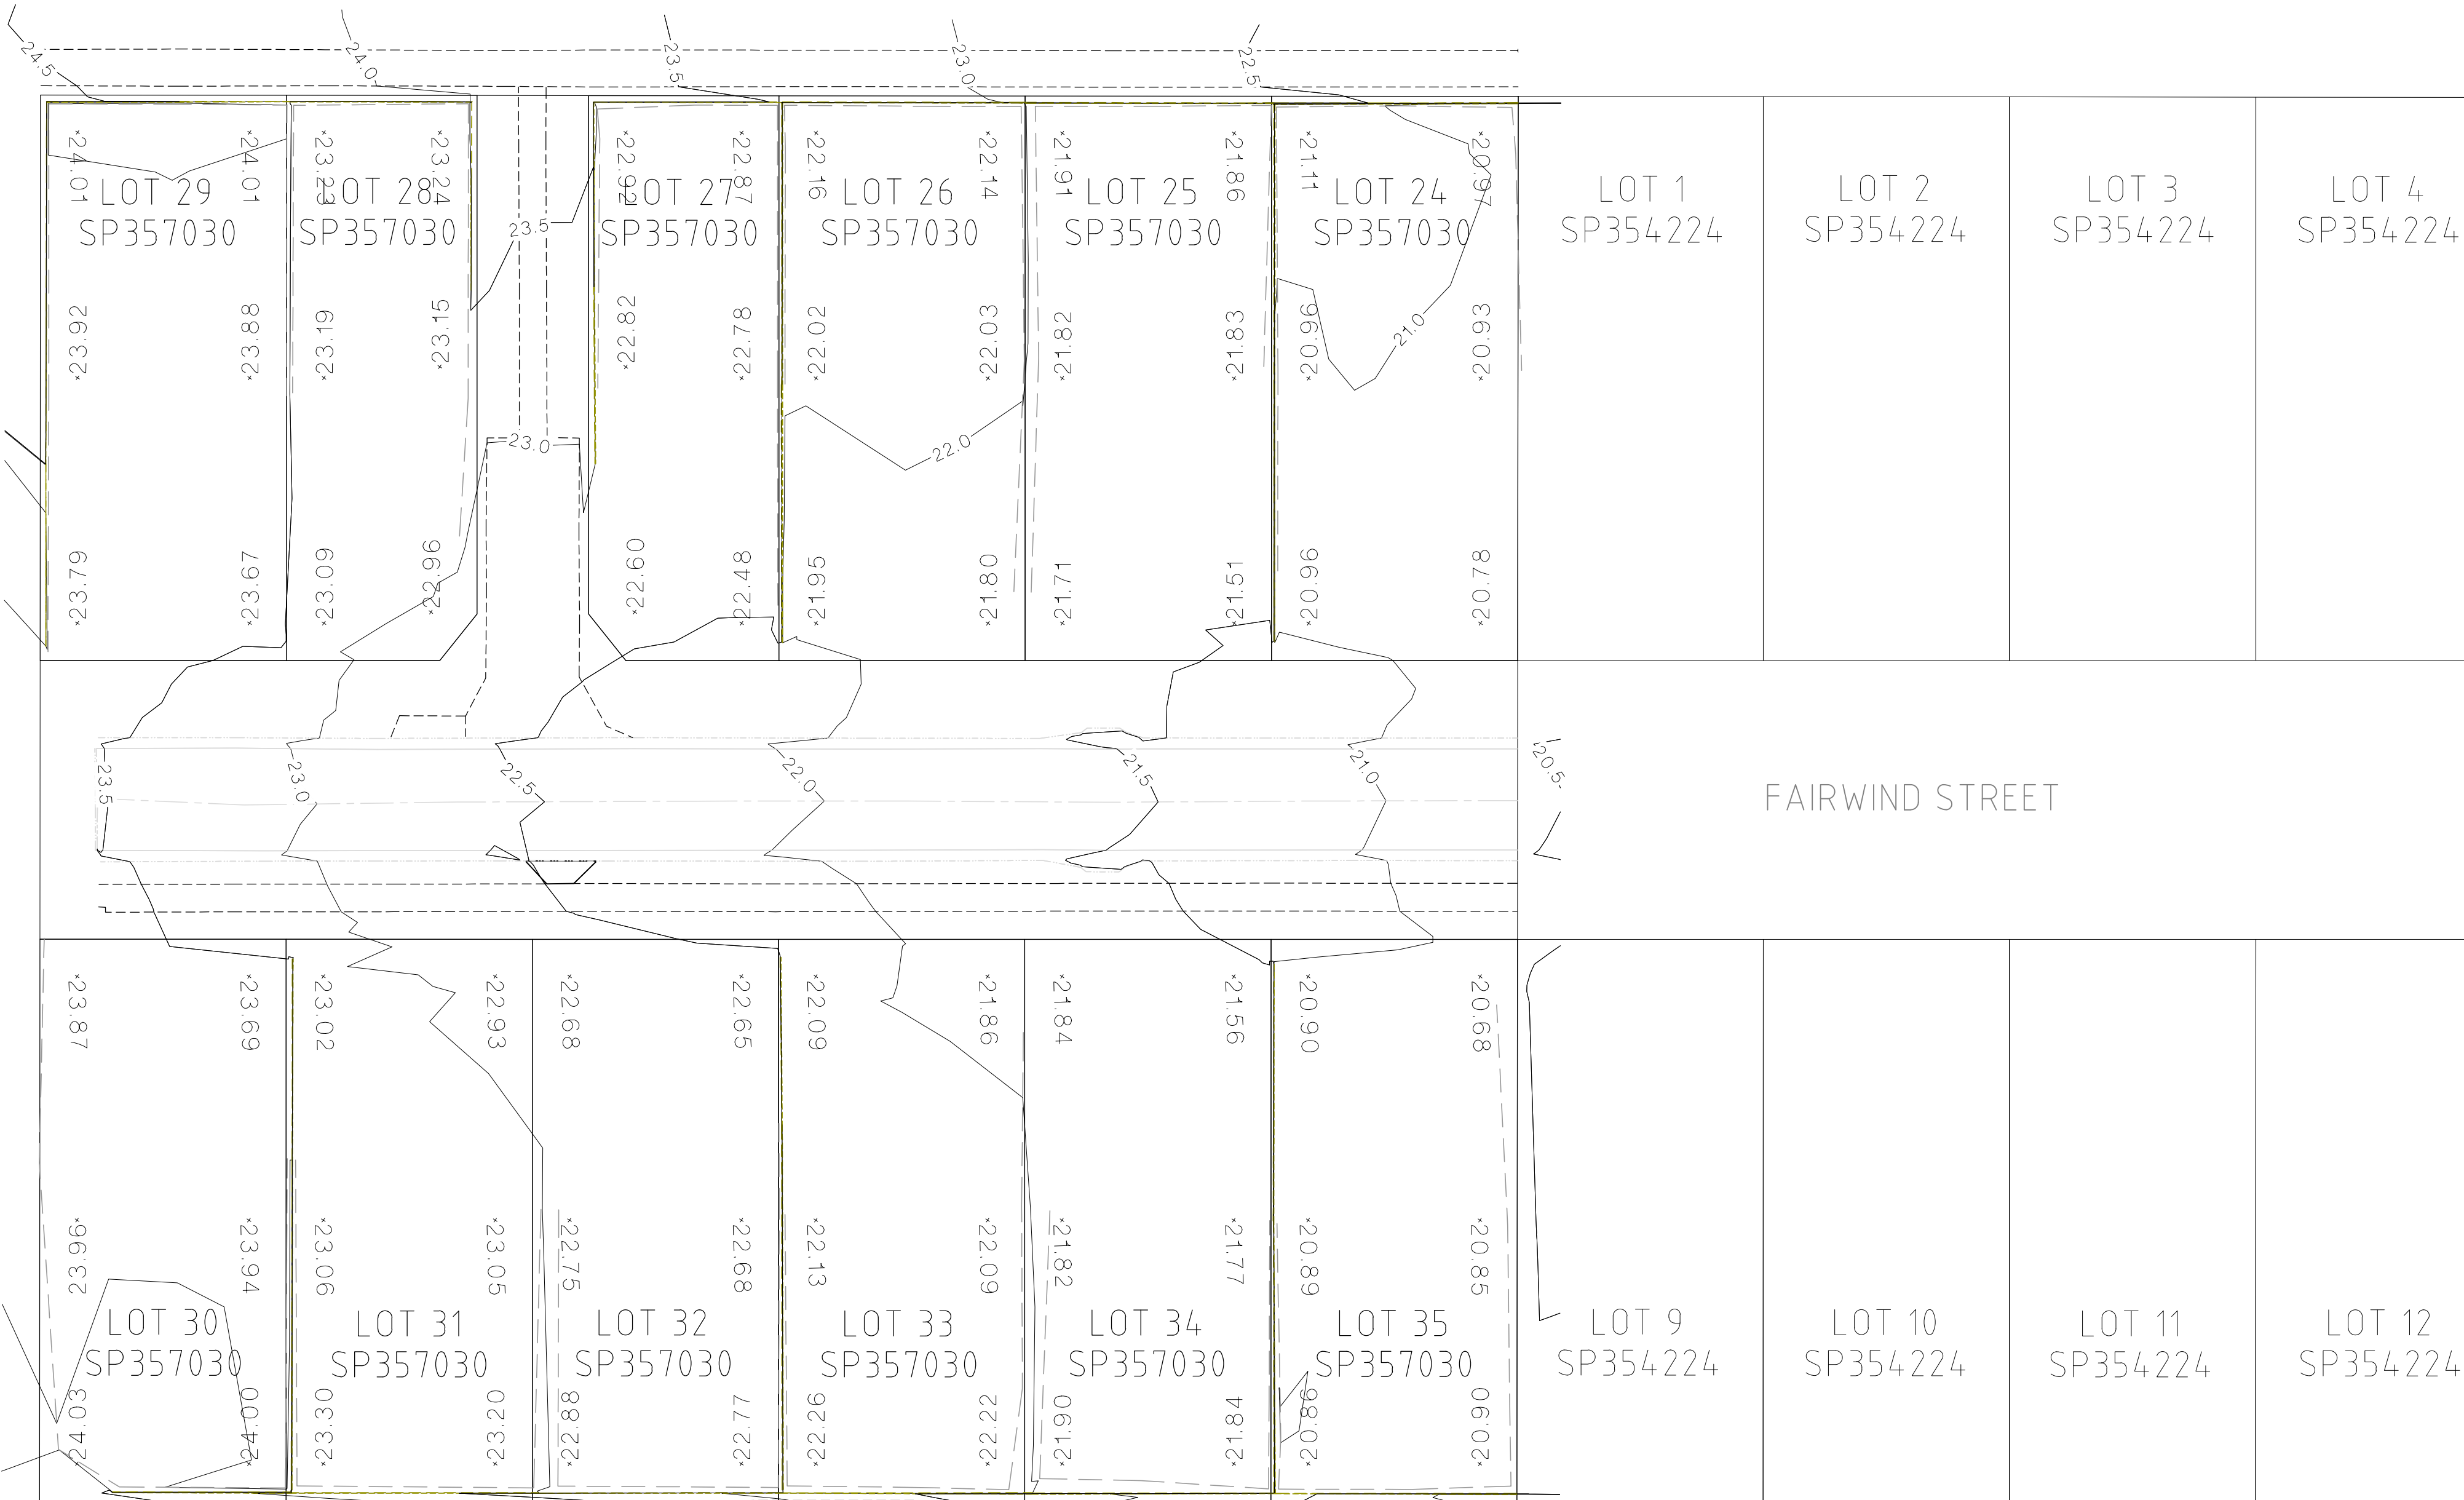

BARCREST DRIVE

FAIRWIND STREET



CLIENT

ORCHARD
PROPERTY GROUP

PROJECT

AS CONSTRUCTED
TOPOGRAPHY
OF
STAGE 2,
4 BARCREST DRIVE, VICTORIA POINT

LEGEND

BOTTOM OF WALL

TOP OF WALL

LIP OF KERB

BACK OF KERB

EDGE OF CONCRETE

EDGE OF ROCK

CONTOURS

CHANGE OF GRADE

BOTTOM OF BANK

TOP OF BANK

CROWN OF ROAD

ENGINEER'S CERTIFICATION


I, _____, hereby certify that the as-constructed details shown on this drawing are a true and accurate record of the construction works, in compliance with the contract documents, approved drawings and approved design.

RPEQ (signature) RPEQ No. _____ Date: _____

REGISTERED CADASTRAL SURVEYOR (QLD) CERTIFICATION

MNG QLD & NSW Pty Ltd, hereby certify that the vertical and horizontal locations and dimensions shown on this plan are a true and accurate record and were located by survey.


Authorised Delegate Reg. Surveyor No. _ 4118 _ Date: 17/08/2026
MNG QLD & NSW Pty Ltd
Registered QLD Surveyor Corporation

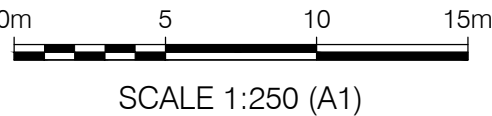

ENGINEERING FIRM:

BURCHILLS ENGINEERING
SOLUTIONS PTY LTD

1	17/08/2026	MJK	CGW	CGW	INITIAL ISSUE
REV	DATE	DRAWN	CHECKED	APPROVED	NOTE



Brisbane Office
Level 3
108 Wickham Street
Fortitude Valley QLD 4006
p: (07) 3842 1000
e: brisbane@mngsurvey.com.au
w: mngsurvey.com.au

Perth | Brisbane | Melbourne | Sydney | Broome | South West WA

LEVEL DATUM
AHD

LOCAL AUTHORITY
REDLAND C.C.

LEVEL ORIGIN
-

CONTOUR INTERVAL
0.5 Metre

MERIDIAN
MGA2020

CO-ORD SYSTEM
MGA ZONE 56

UDN

SHEET 1 OF 1

BRSS8434-006-41-1

© MNG Survey 2026