


BARCREST DRIVE

LEGEND

- (FH) FIRE HYDRANT/(DFH) DUCKFOOT
- ⊗ (VS) STOP VALVE
- (TB) TAPPING BAND
- ⊞ (BV) BALL VALVE (SEQ 20Ø)
- ┘ END CAP
- └ TEE
- < (RE) REDUCER
- BEND

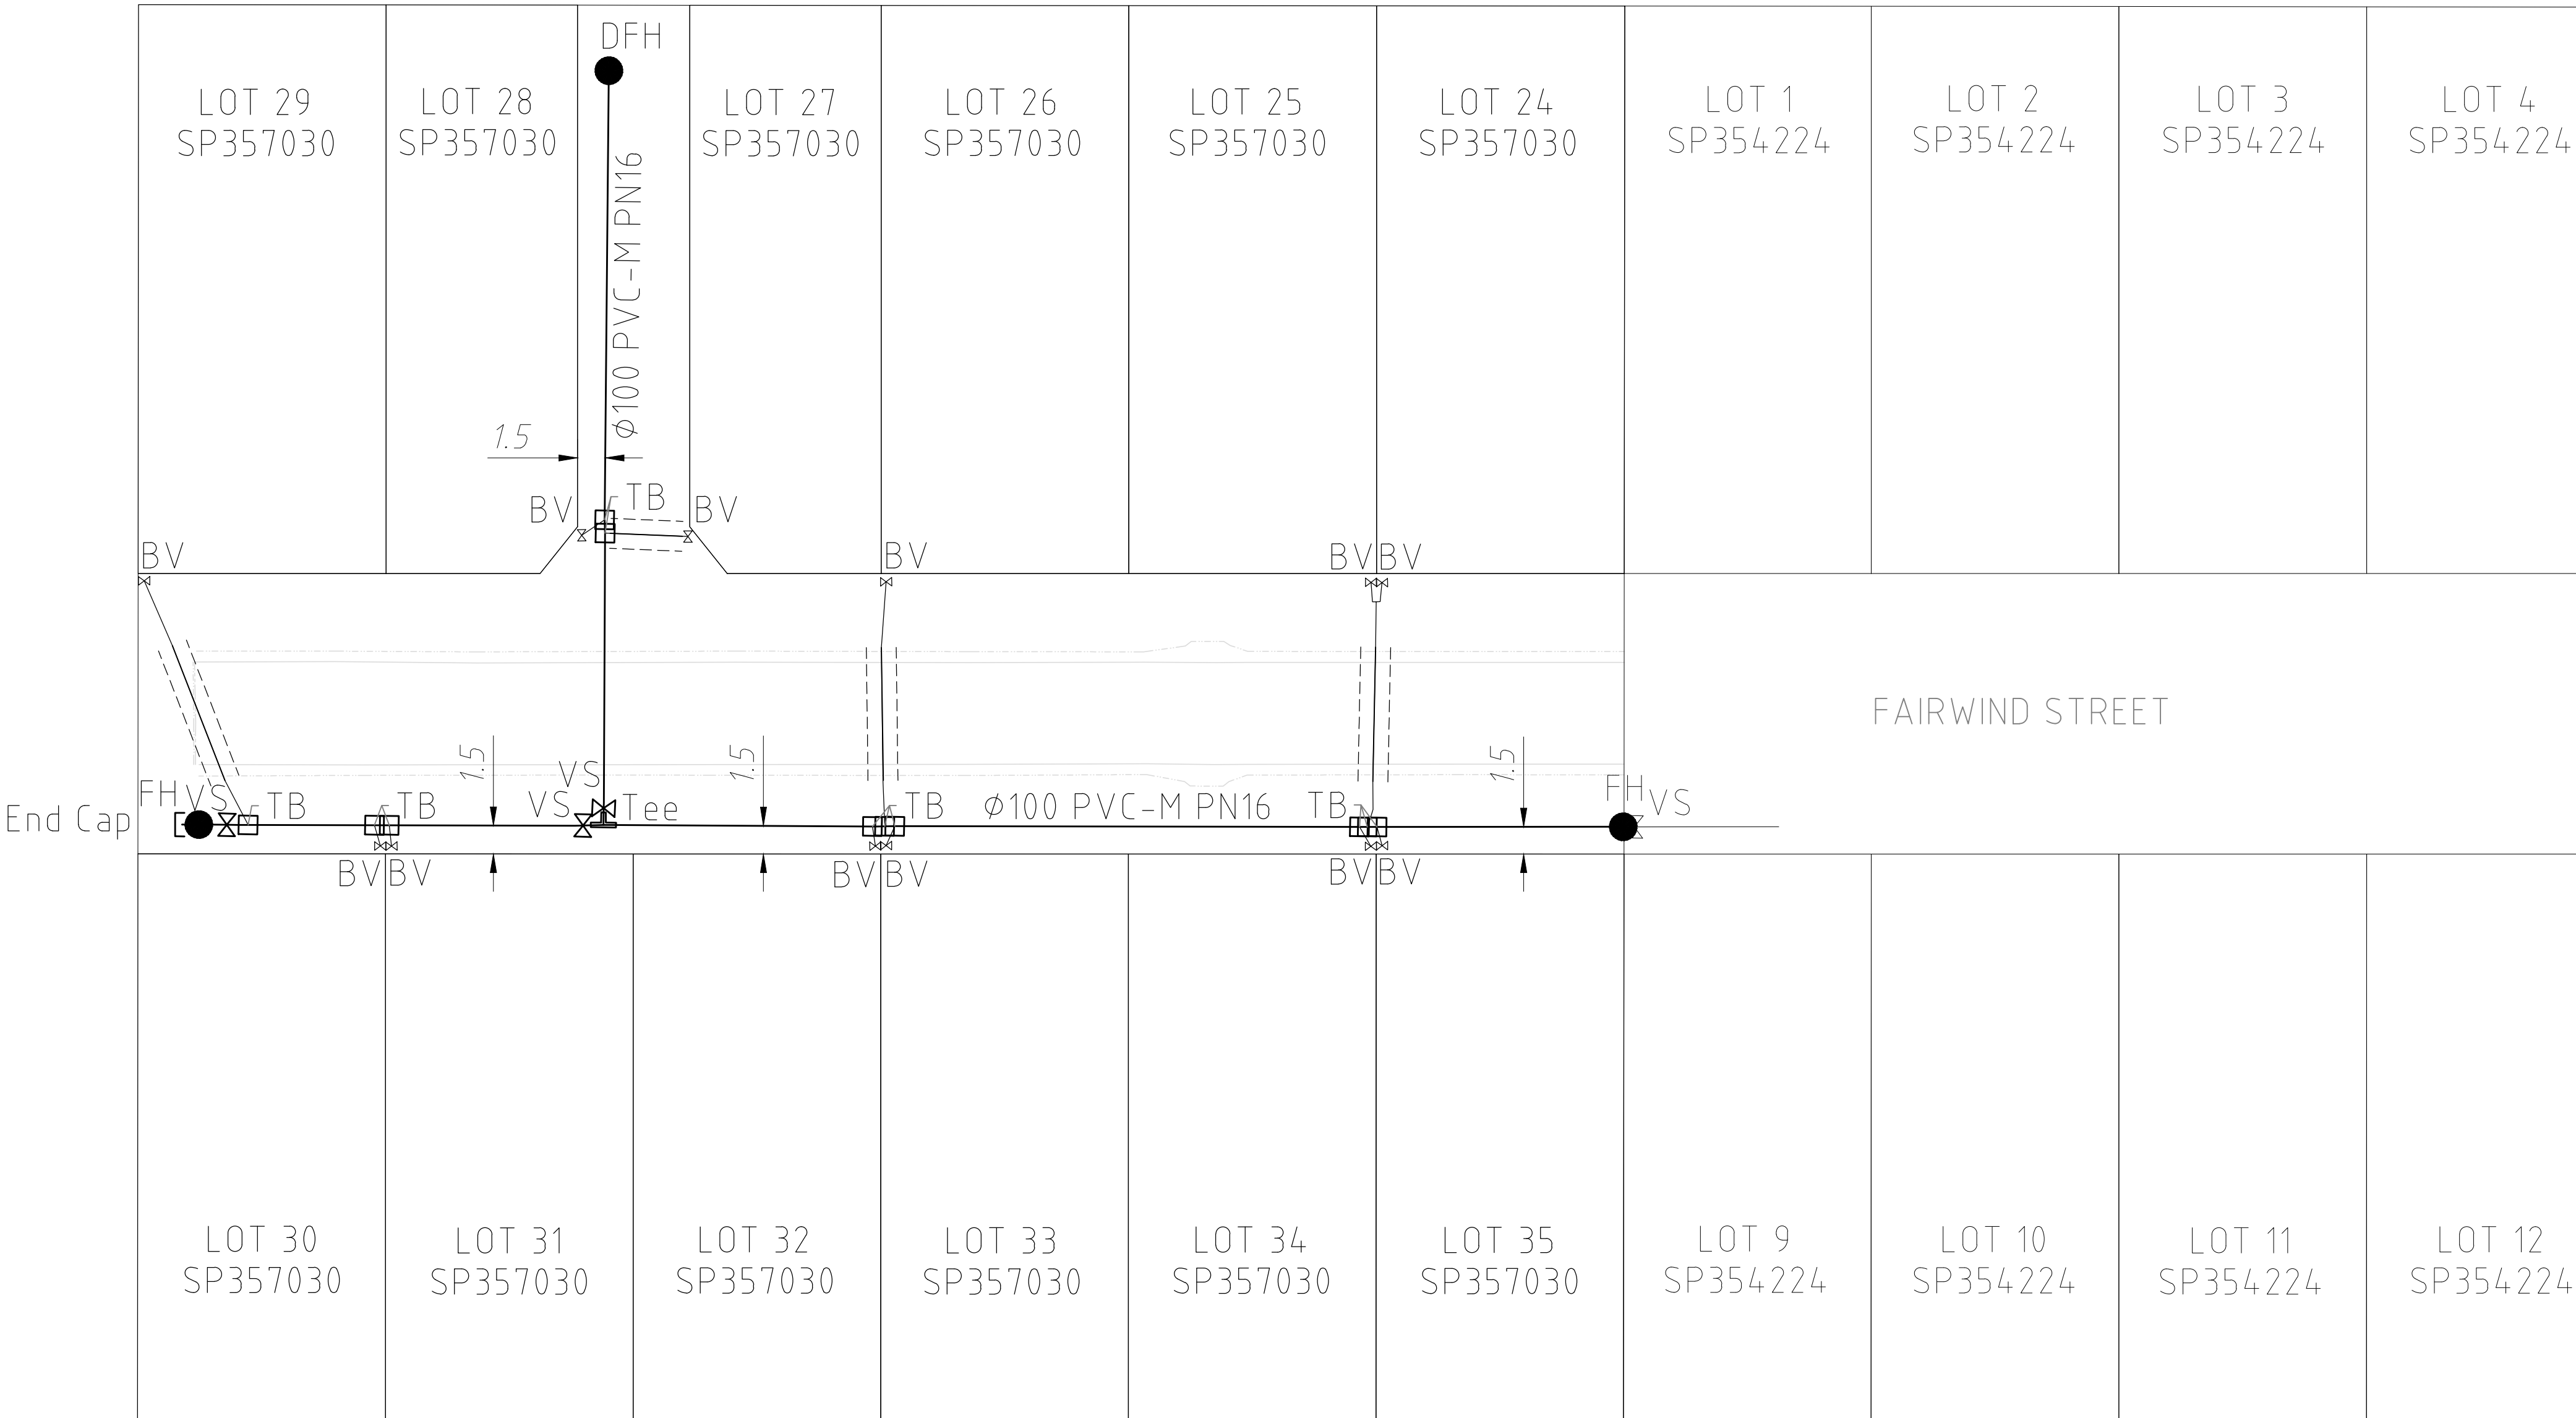

CLIENT

ORCHARD
PROPERTY GROUP

PROJECT

AS CONSTRUCTED
WATER RETICULATION
OF
STAGE 4
6 BARCREST DRIVE, VICTORIA POINT

NOTES

-ALL WATER RETICULATION MAINS ARE
Ø100 PVC-M, PN16 U.N.O.

-ALL FIRE HYDRANTS ARE Ø100 SPRING
U.N.O.

-WATER METERS TO BE INSTALLED BY
COUNCIL

-WATER LIVE CONNECTIONS TO BE
COMPLETED BY COUNCIL

ENGINEERING FIRM:

BURCHILLS ENGINEERING
SOLUTIONS PTY LTD

ENGINEER'S CERTIFICATION


I, _____, hereby certify that the as-constructed details shown on this drawing are a true and accurate record of the construction works, in compliance with the contract documents, approved drawings and approved design.

RPEQ (signature) _____ RPEQ No. _____ Date: _____

REGISTERED CADASTRAL SURVEYOR (QLD) CERTIFICATION

MNG QLD & NSW Pty Ltd, hereby certify that the vertical and horizontal locations and dimensions shown on this plan are a true and accurate record and were located by survey.

C. Walker
Authorised Delegate Reg. Surveyor No. _ 4118 _ Date: 06/08/2026
MNG QLD & NSW Pty Ltd
Registered QLD Surveyor Corporation

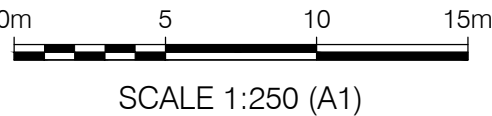

1	06/08/2026	MJK	CGW	CGW	04/08/2026
REV	DATE	DRAWN	CHECKED	APPROVED	SURVEY DATE

MNG

Brisbane Office
Level 3
108 Wickham Street
Fortitude Valley QLD 4006
p: (07) 3842 1000
e: brisbane@mngsurvey.com.au
w: mngsurvey.com.au

Perth | Brisbane | Melbourne | Sydney | Broome | South West WA

LEVEL DATUM AHD	LOCAL AUTHORITY REDLAND C.C.
LEVEL ORIGIN -	CONTOUR INTERVAL -
MERIDIAN MGA2020	CO-ORD SYSTEM MGA ZONE 56
UDN	SHEET 1 OF 1

BRSS8434-006-44-1

© MNG Survey 2026