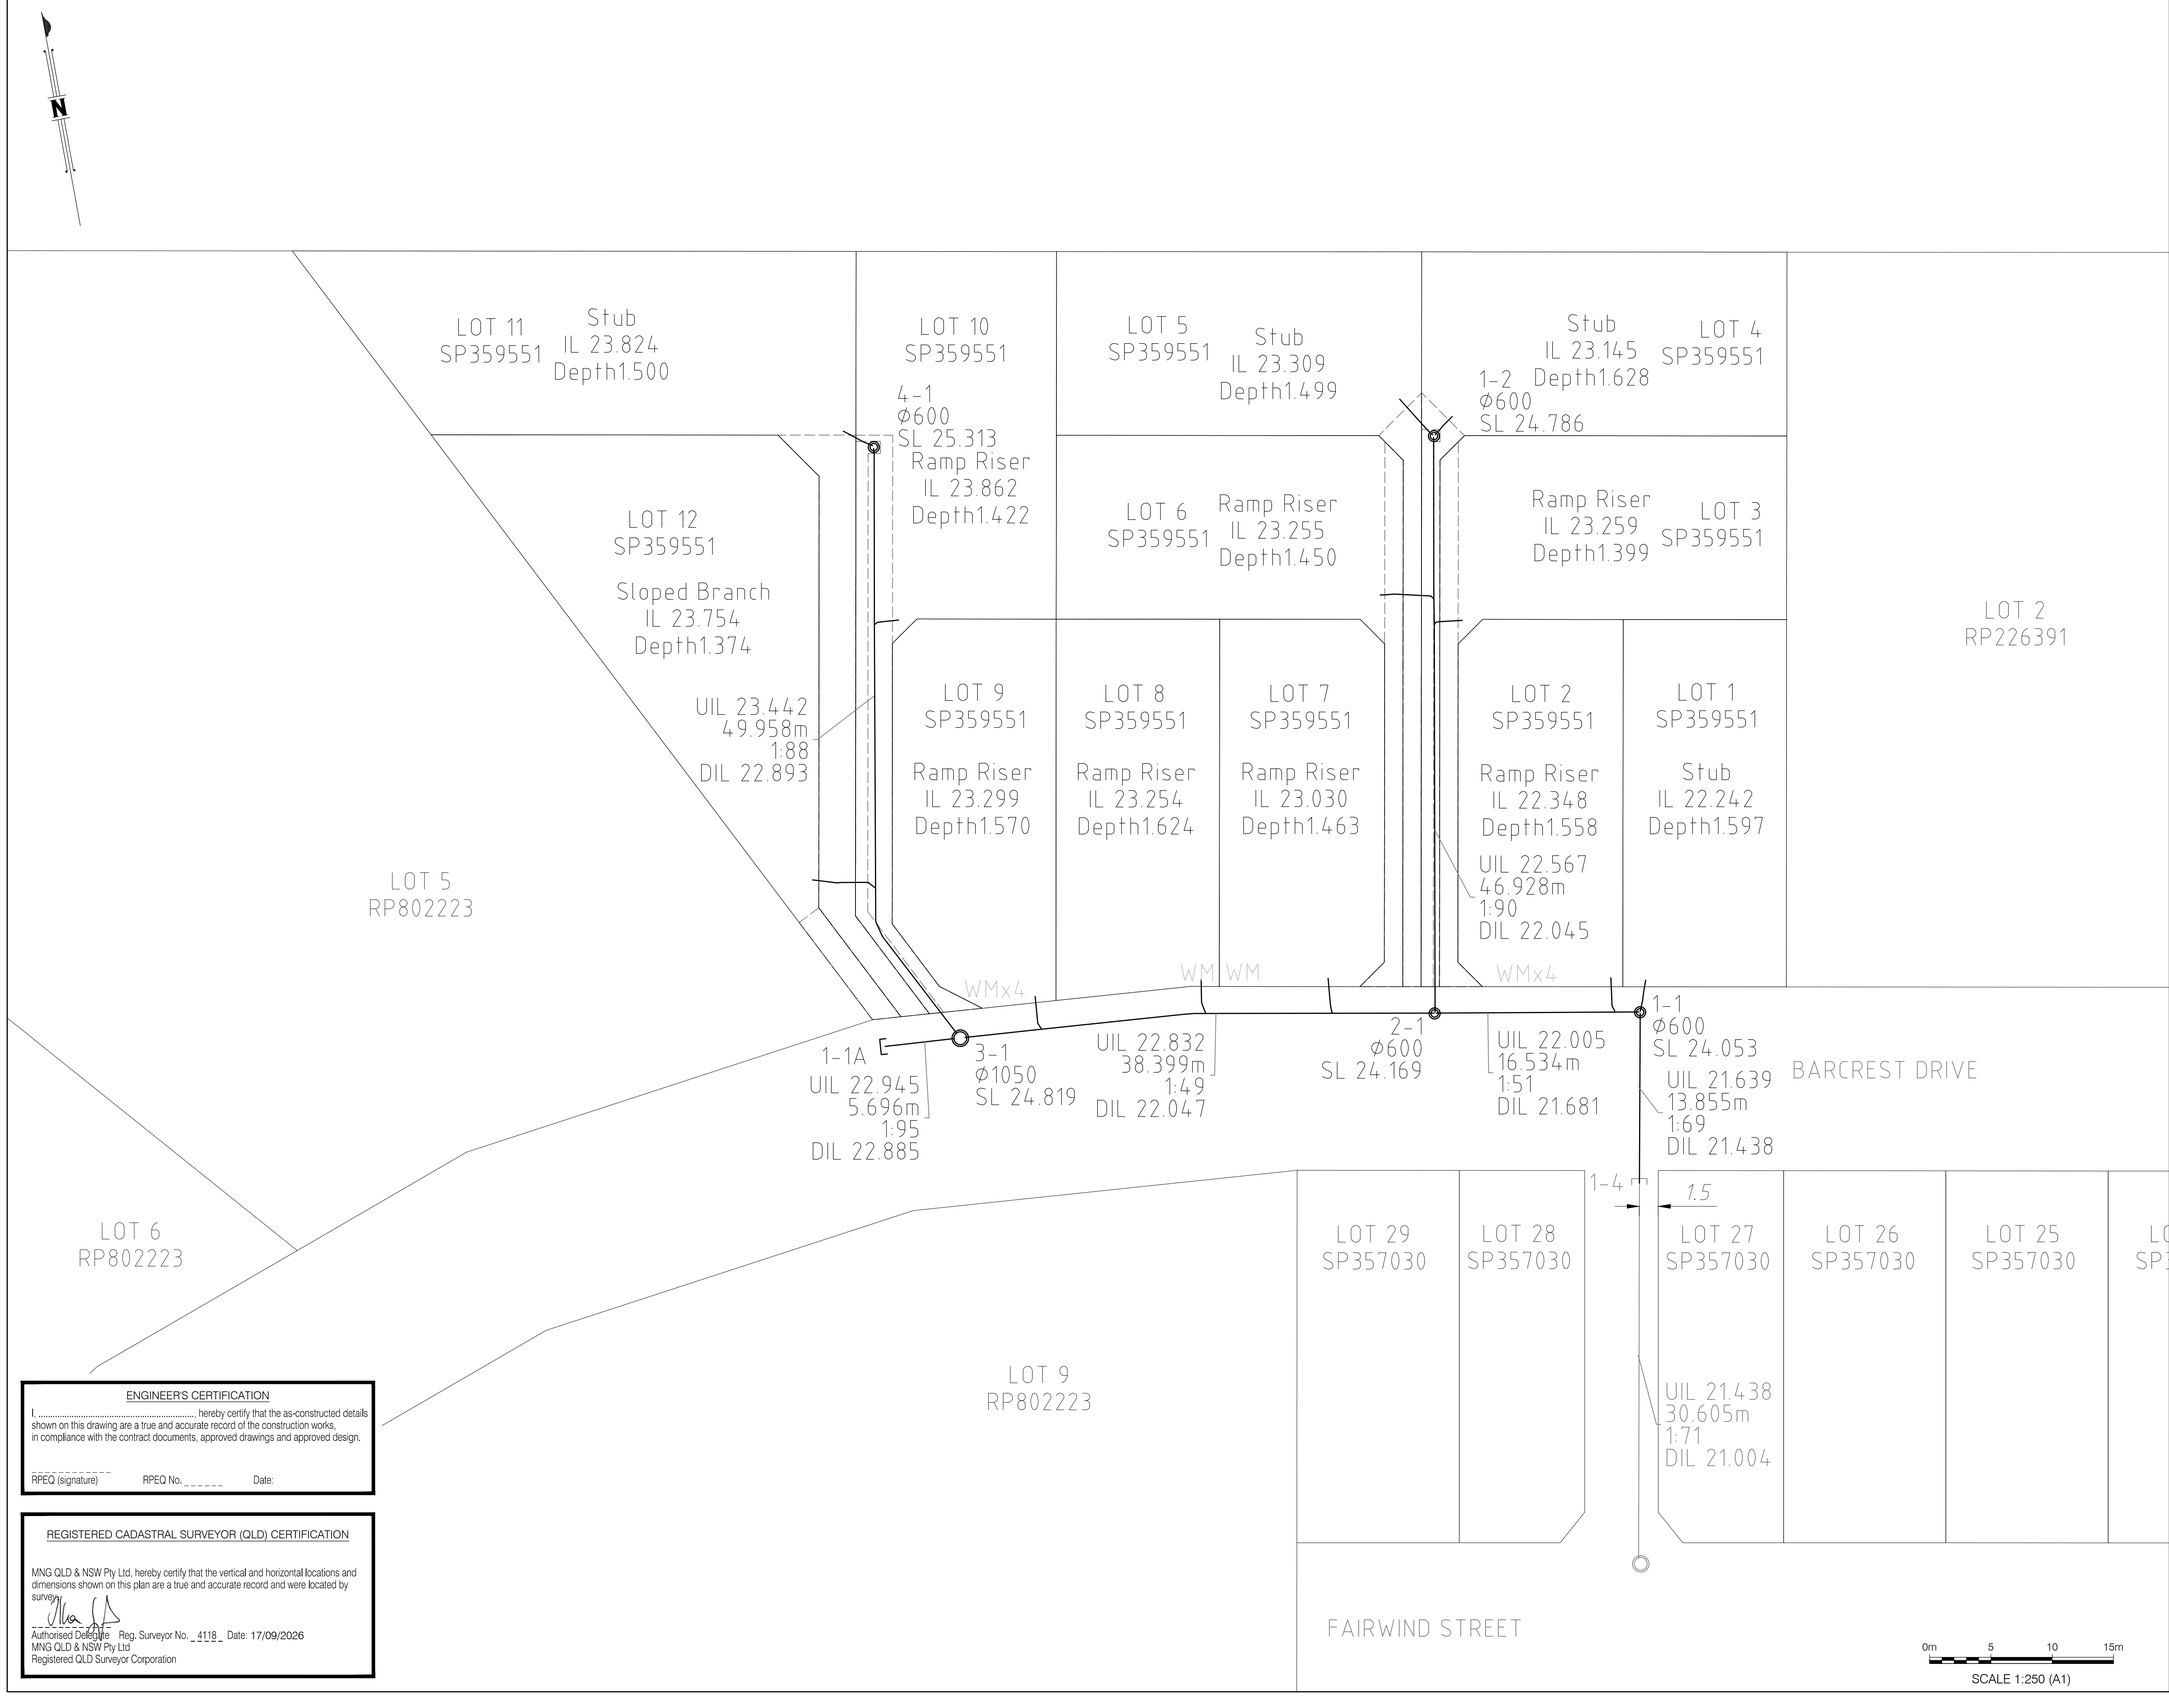

ENGINEER'S CERTIFICATION

I, ..., hereby certify that the as-constructed details shown on this drawing are a true and accurate record of the construction works, in compliance with the contract documents, approved drawings and approved design.

_____
RPEQ (signature) RPEQ No. _____ Date:

REGISTERED CADASTRAL SURVEYOR (QLD) CERTIFICATION

MNG QLD & NSW Pty Ltd, hereby certify that the vertical and horizontal locations and dimensions shown on this plan are a true and accurate record and were located by survey.

Authorised Delegate Reg. Surveyor No. _4118_ Date: 17/09/2026
MNG QLD & NSW Pty Ltd
Registered QLD Surveyor Corporation

CLIENT

ORCHARD
PROPERTY GROUP

PROJECT

AS CONSTRUCTED SEWER
OF
STAGE 3
5 BARCREST DRIVE, VICTORIA POINT

NOTES

-ALL SEWER RETICULATION PIPES ARE Ø150 PVC-U SN8 U.N.O.

-ALL SEWER HOUSE CONNECTION PIPES ARE Ø100 PVC-U SN10 U.N.O.

ENGINEERING FIRM:

BURCHILLS ENGINEERING SOLUTIONS PTY LTD

REV	DATE	DRAWN	CHECKED	APPROVED	NOTE
2	17/09/2026	MJK	JV	IS	INITIAL ISSUE
1	14/08/2026	MJK			PRELIMINARY

Brisbane Office
Level 3
108 Wickham Street
Fortitude Valley QLD 4006

p: (07) 3842 1000
e: brisbane@mngsurvey.com.au
w: mngsurvey.com.au

Perth | Brisbane | Melbourne | Sydney | Broome | South West WA

LEVEL DATUM	LOCAL AUTHORITY
AHD	REDLAND C.C.
LEVEL ORIGIN	CONTOUR INTERVAL
-	-
MERIDIAN	CO-ORD SYSTEM
MGA2020	MGA ZONE 56

UDN SHEET 1 OF 1

BRSS8434-005-61-2

© MNG Survey 2026